




Second Floor

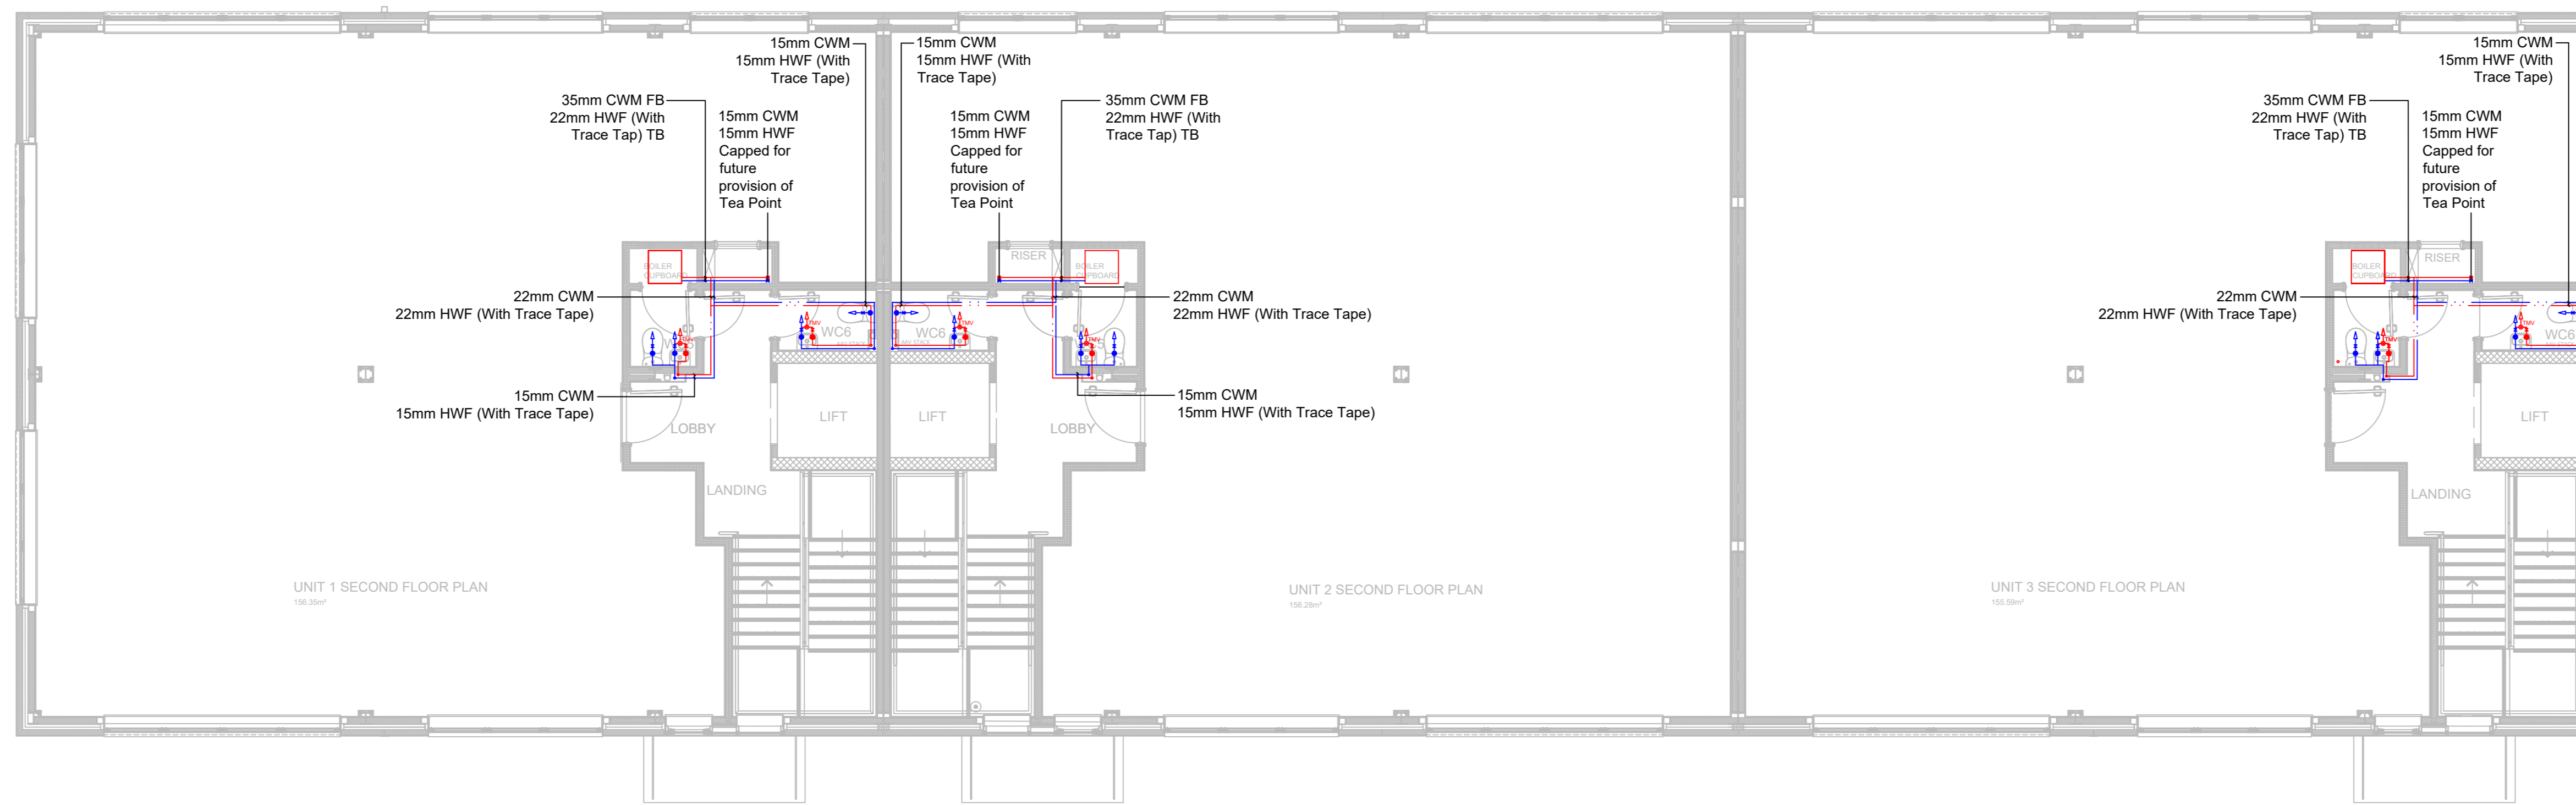

First Floor

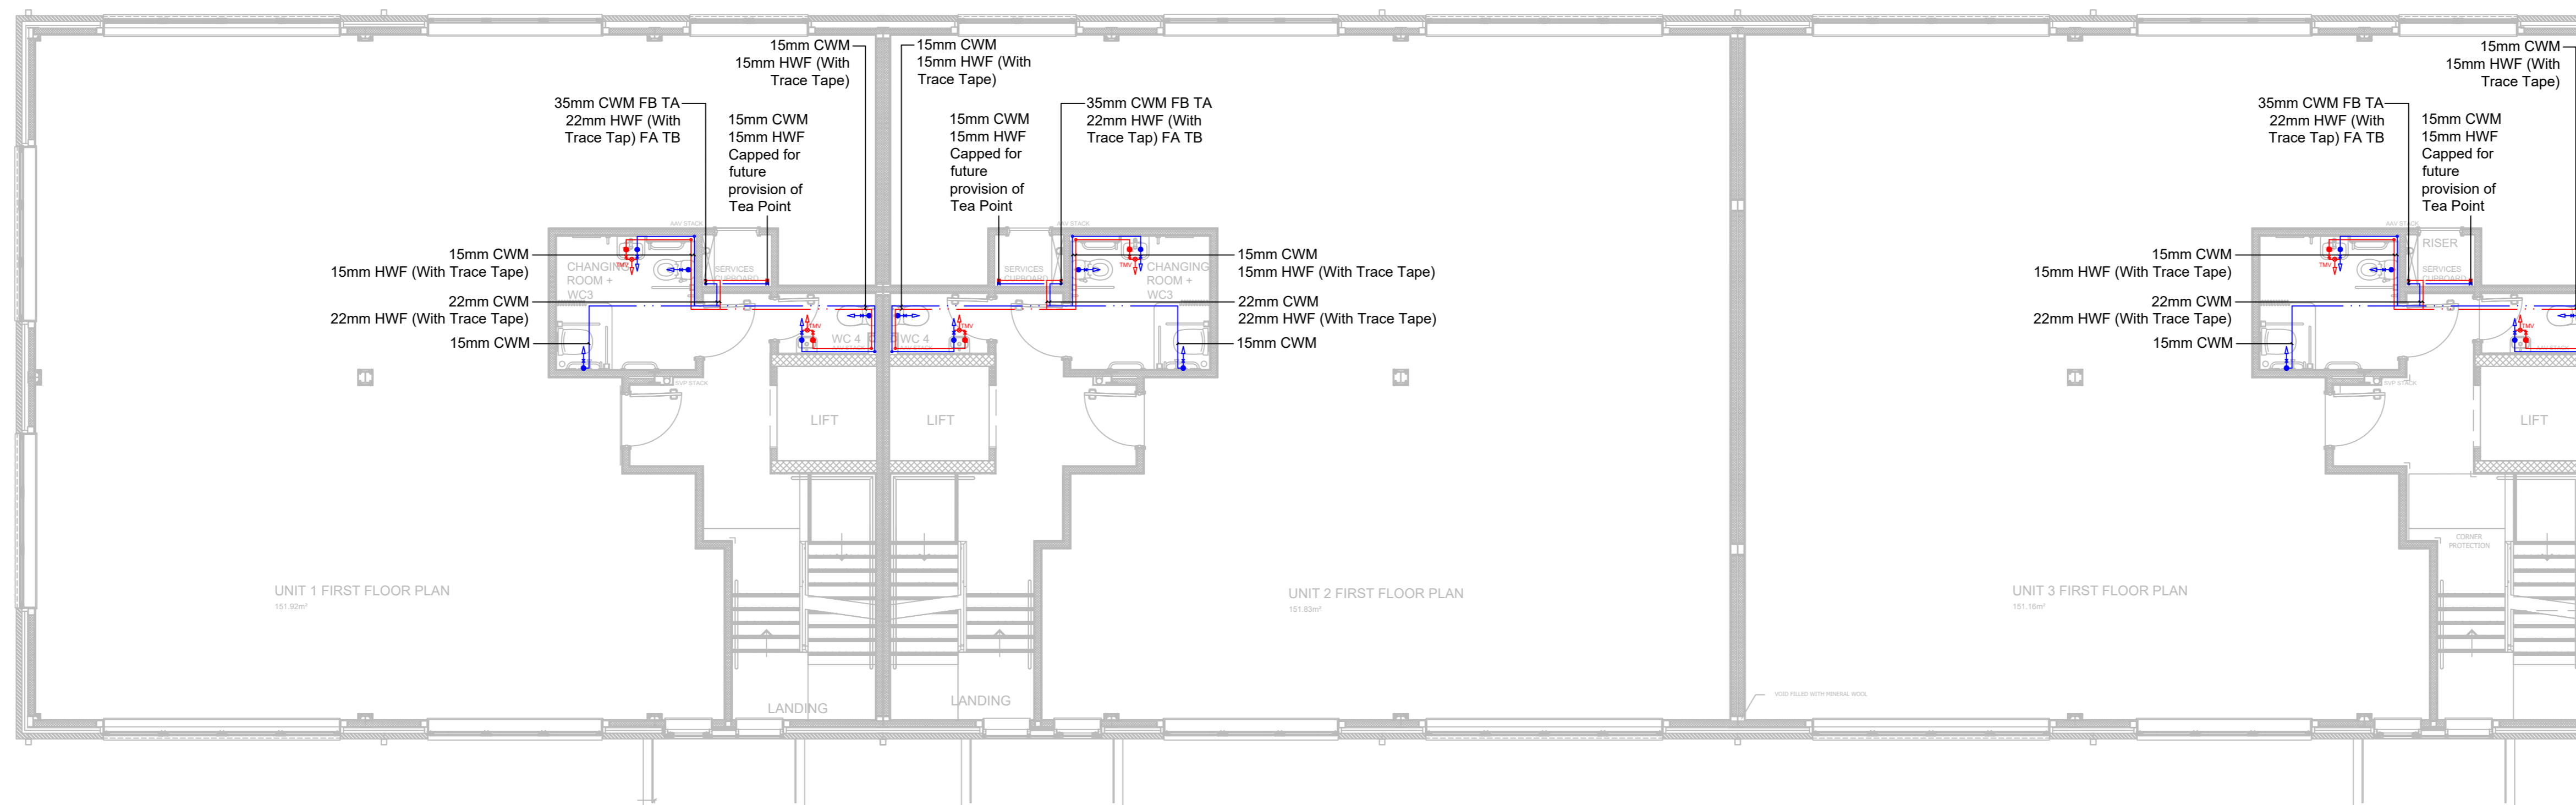


Ground Floor

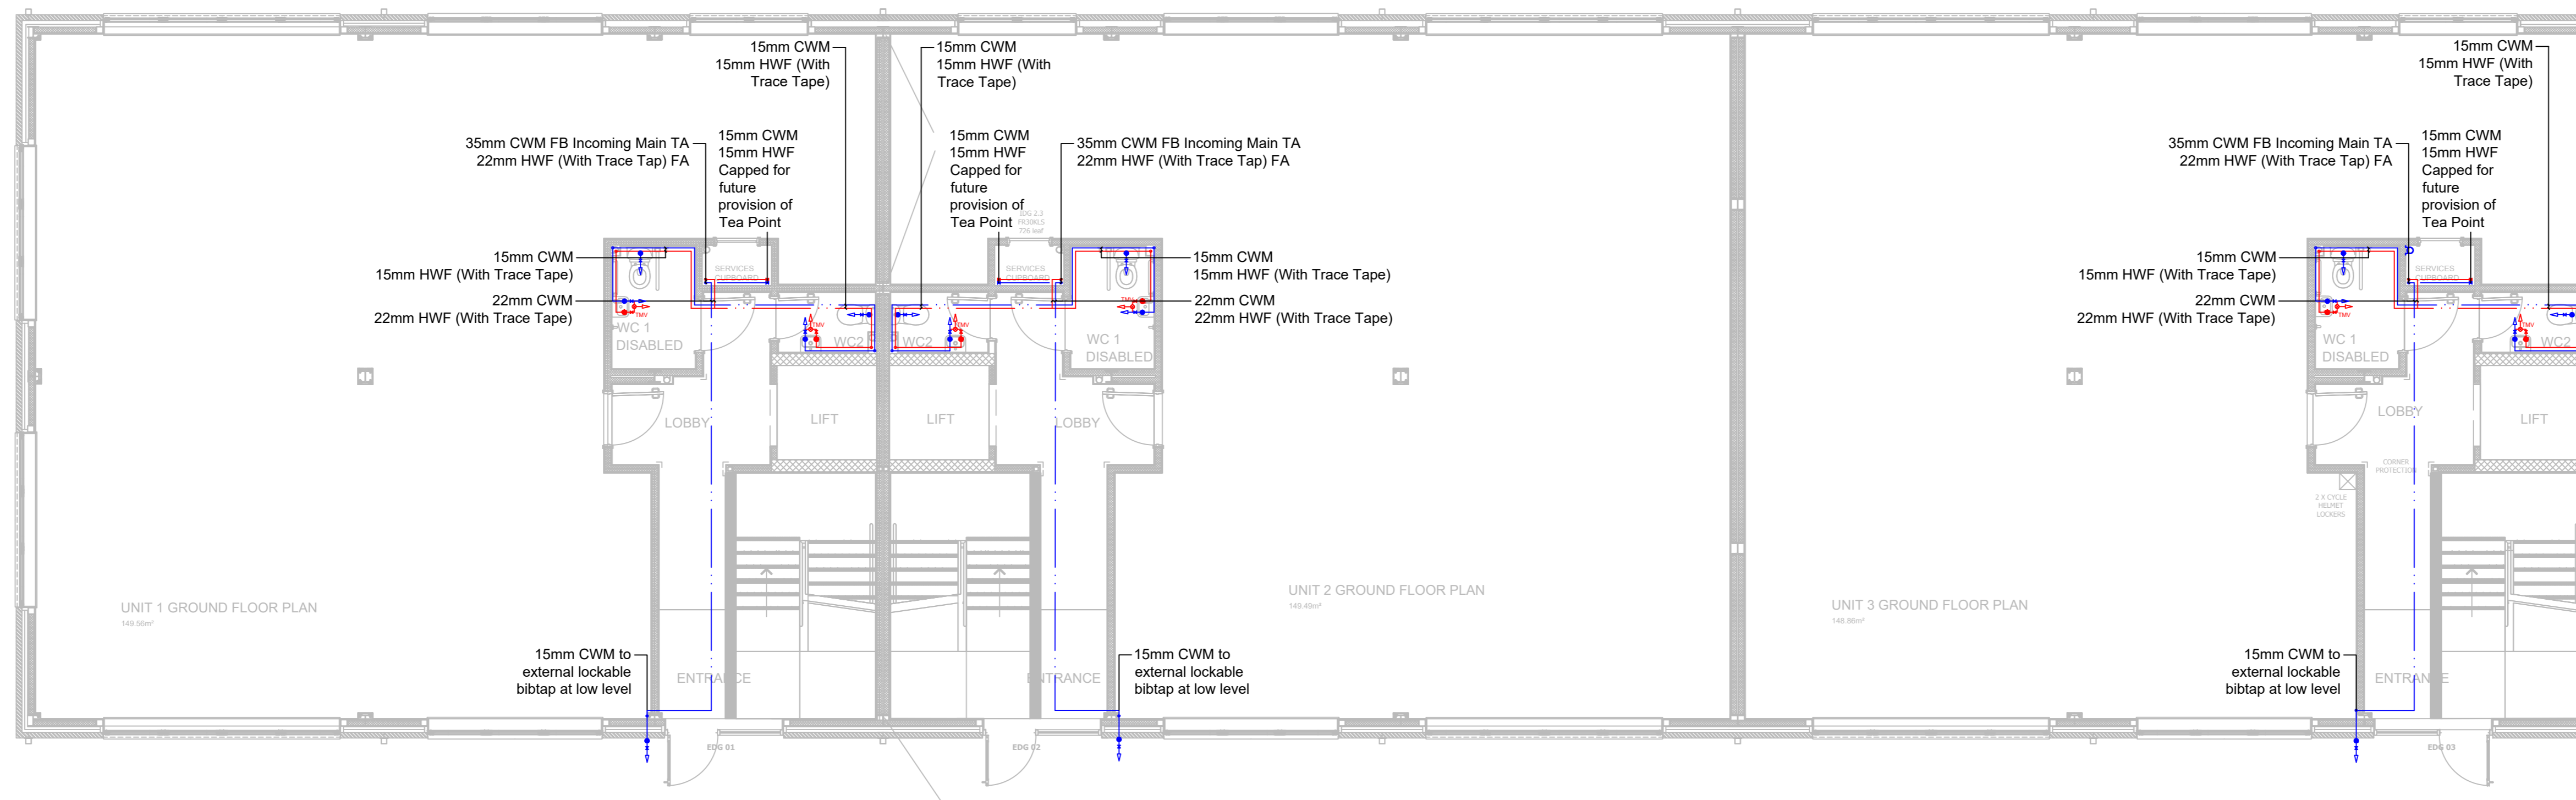

THIS DRAWING IS CONFIDENTIAL & THE COPYRIGHT OF PAINE MANWARING LTD. THE CONTENTS ARE NOT TO BE USED OR COPIED FOR ANY PURPOSE WHATSOEVER WITHOUT OUR PRIOR WRITTEN CONSENT

DO NOT SCALE
ALL DIMENSIONS IN MILLIMETRES EXCEPT WHERE OTHERWISE STATED

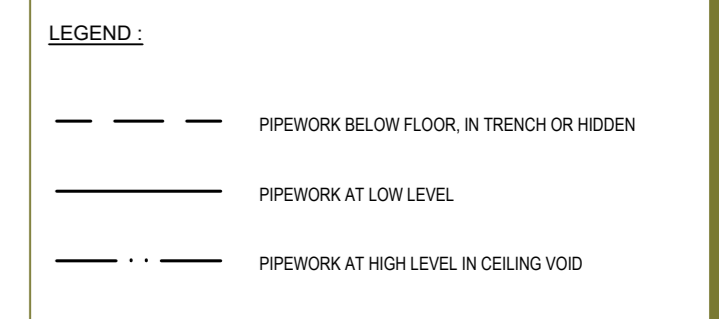

NOTES:

Copper pipework shall be manufactured in accordance with the provisions of EN1057:2002 and BS 2871:1971 and subsequent amendments Table X.

All copper fittings to be Yorkshire Xpress type fittings with certified tools used for crimping.

In all cases where pipes pass through walls, floors, ceilings, etc. pipework sleeves shall be provided and it shall be ensured that the sleeves are correctly built in. Sleeves shall in no cases be used as pipe supports.

All thermal insulation shall comply with building regulations relating to thermal insulation of pipes with the thickness complying with BS 5422:1977.

Pipework shall be thermally insulated within cupboards, voids, ducts, below floor level and within roof voids. Where joints and off-sets occur the insulation shall be lapped to suit.

All outlets are to be fitted with individual isolation valves with integral flow restrictors.

All hot water outlets are to be blended by TRV's type valves with integral isolation and strainers.

All floors to have isolation valves for maintenance purposes.

| NO | RECORD DRAWING | DATE |
|----|---------------------|----------|
| 01 | RECORD DRAWING | 20/04/18 |
| 02 | REVISED LAYOUT | 20/04/18 |
| 03 | CONSTRUCTION | 20/04/18 |
| 04 | REVISED LAYOUT | 20/04/18 |
| 05 | ISSUED FOR APPROVAL | 20/04/18 |
| 06 | DESCRIPTION | 20/04/18 |
| 07 | REVISIONS | 20/04/18 |

PaineManwaring
Heating • Plumbing • Electrical

Unit D, Easting Trading Estate
Dumfries Way, Hove, Brighton
West Sussex BN14 8HQ

Tel: (01903) 237522
Fax: (01903) 236511
Email: enquiries@paimanwaring.co.uk
Web: www.paimanwaring.co.uk

STATUS: **RECORD DRAWING**

CLIENT: **W.Stirland**

PROJECT: **Block B Southern Gate
Southern Sidings, Chichester**

TITLE: **Domestic Water Services**

| SCALE | DESIGNED |
|-----------------|----------|
| 1:75@A0 | CPH |
| CONTRACT NUMBER | DRAWN |
| CH035043 | CPH |
| DATE | CHECKED |
| 30.04.2018 | MAL |
| DRAWING NUMBER | REVISION |
| M201 | RD |