



THIS DRAWING IS CONFIDENTIAL & THE COPYRIGHT OF PAINE MANWARING LTD. THE CONTENTS ARE NOT TO BE USED OR COPIED FOR ANY PURPOSE WHATSOEVER WITHOUT OUR PRIOR WRITTEN CONSENT

DO NOT SCALE

ALL DIMENSIONS IN MILLIMETRES EXCEPT WHERE OTHERWISE STATED

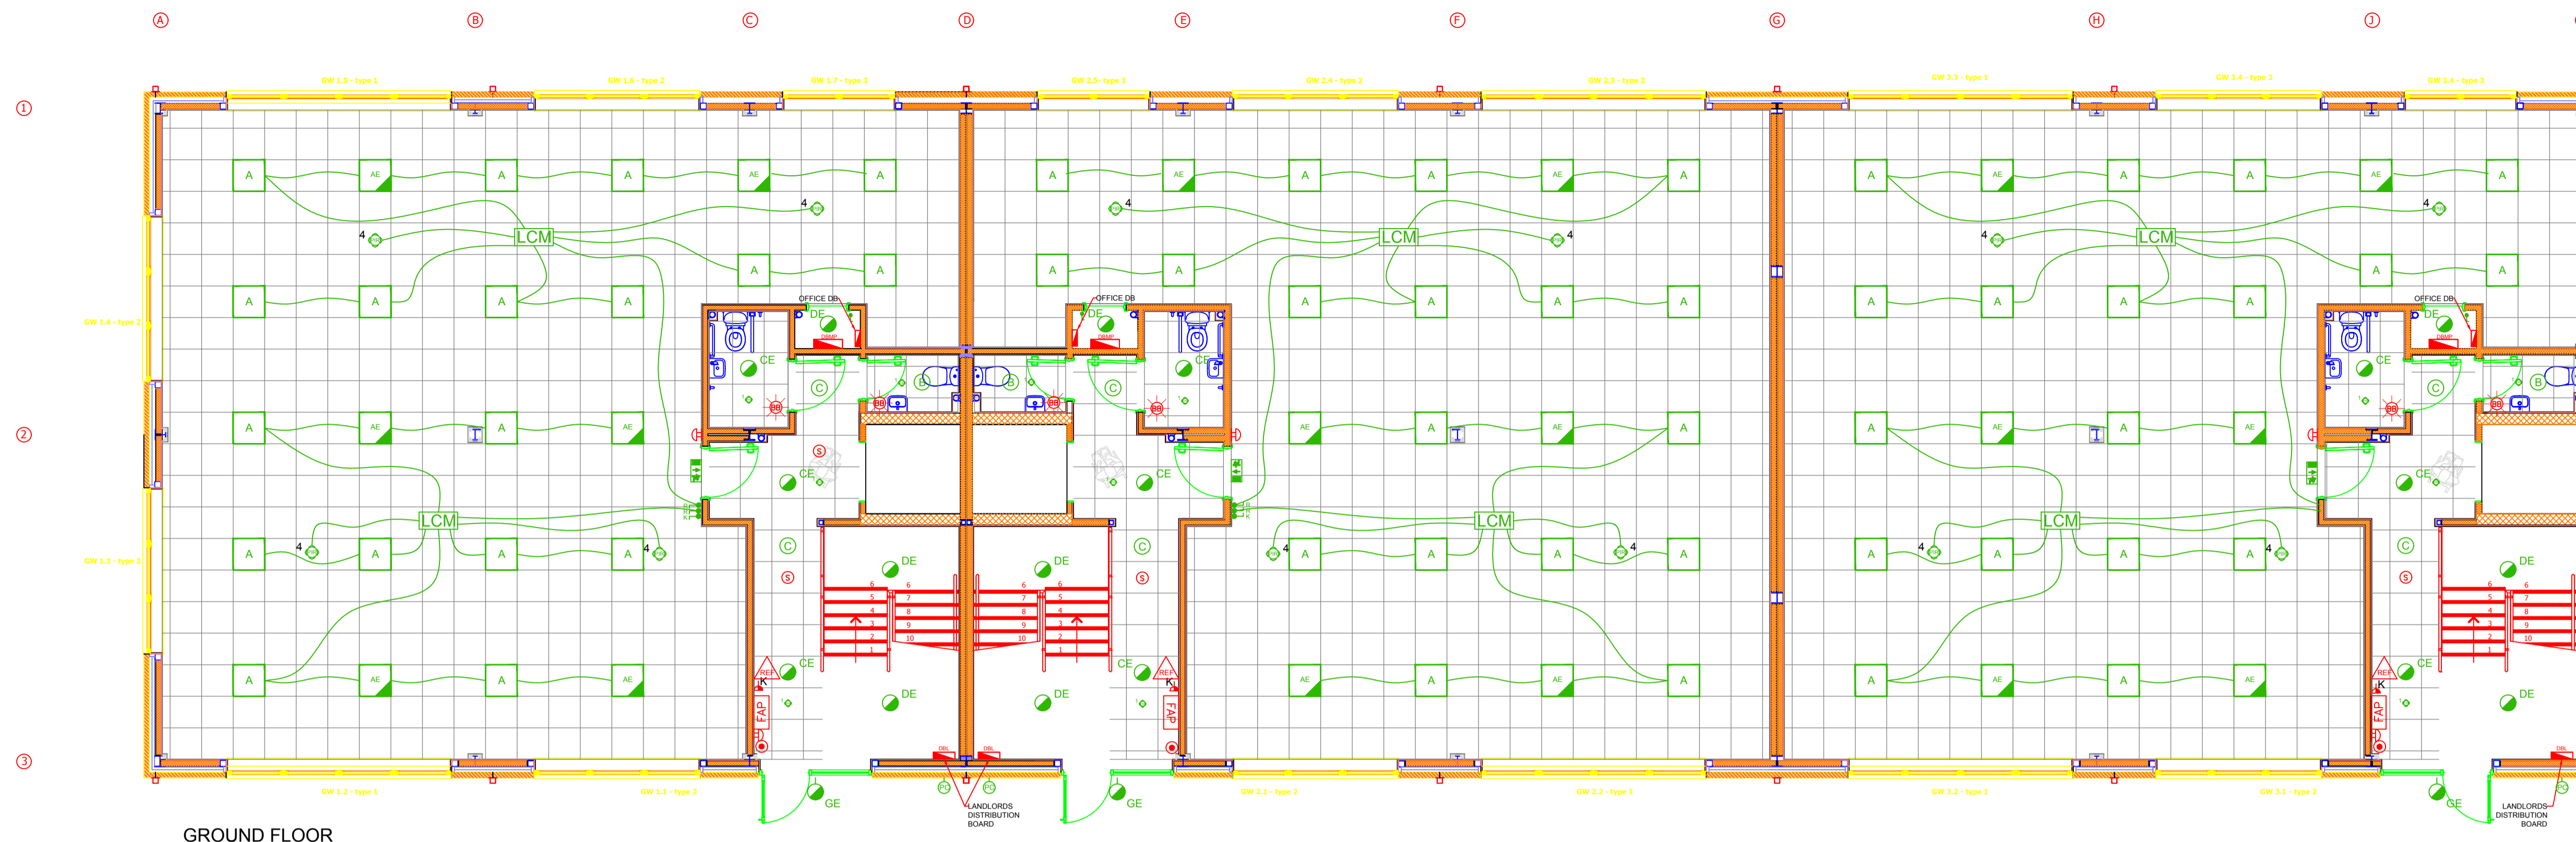

GROUND FLOOR

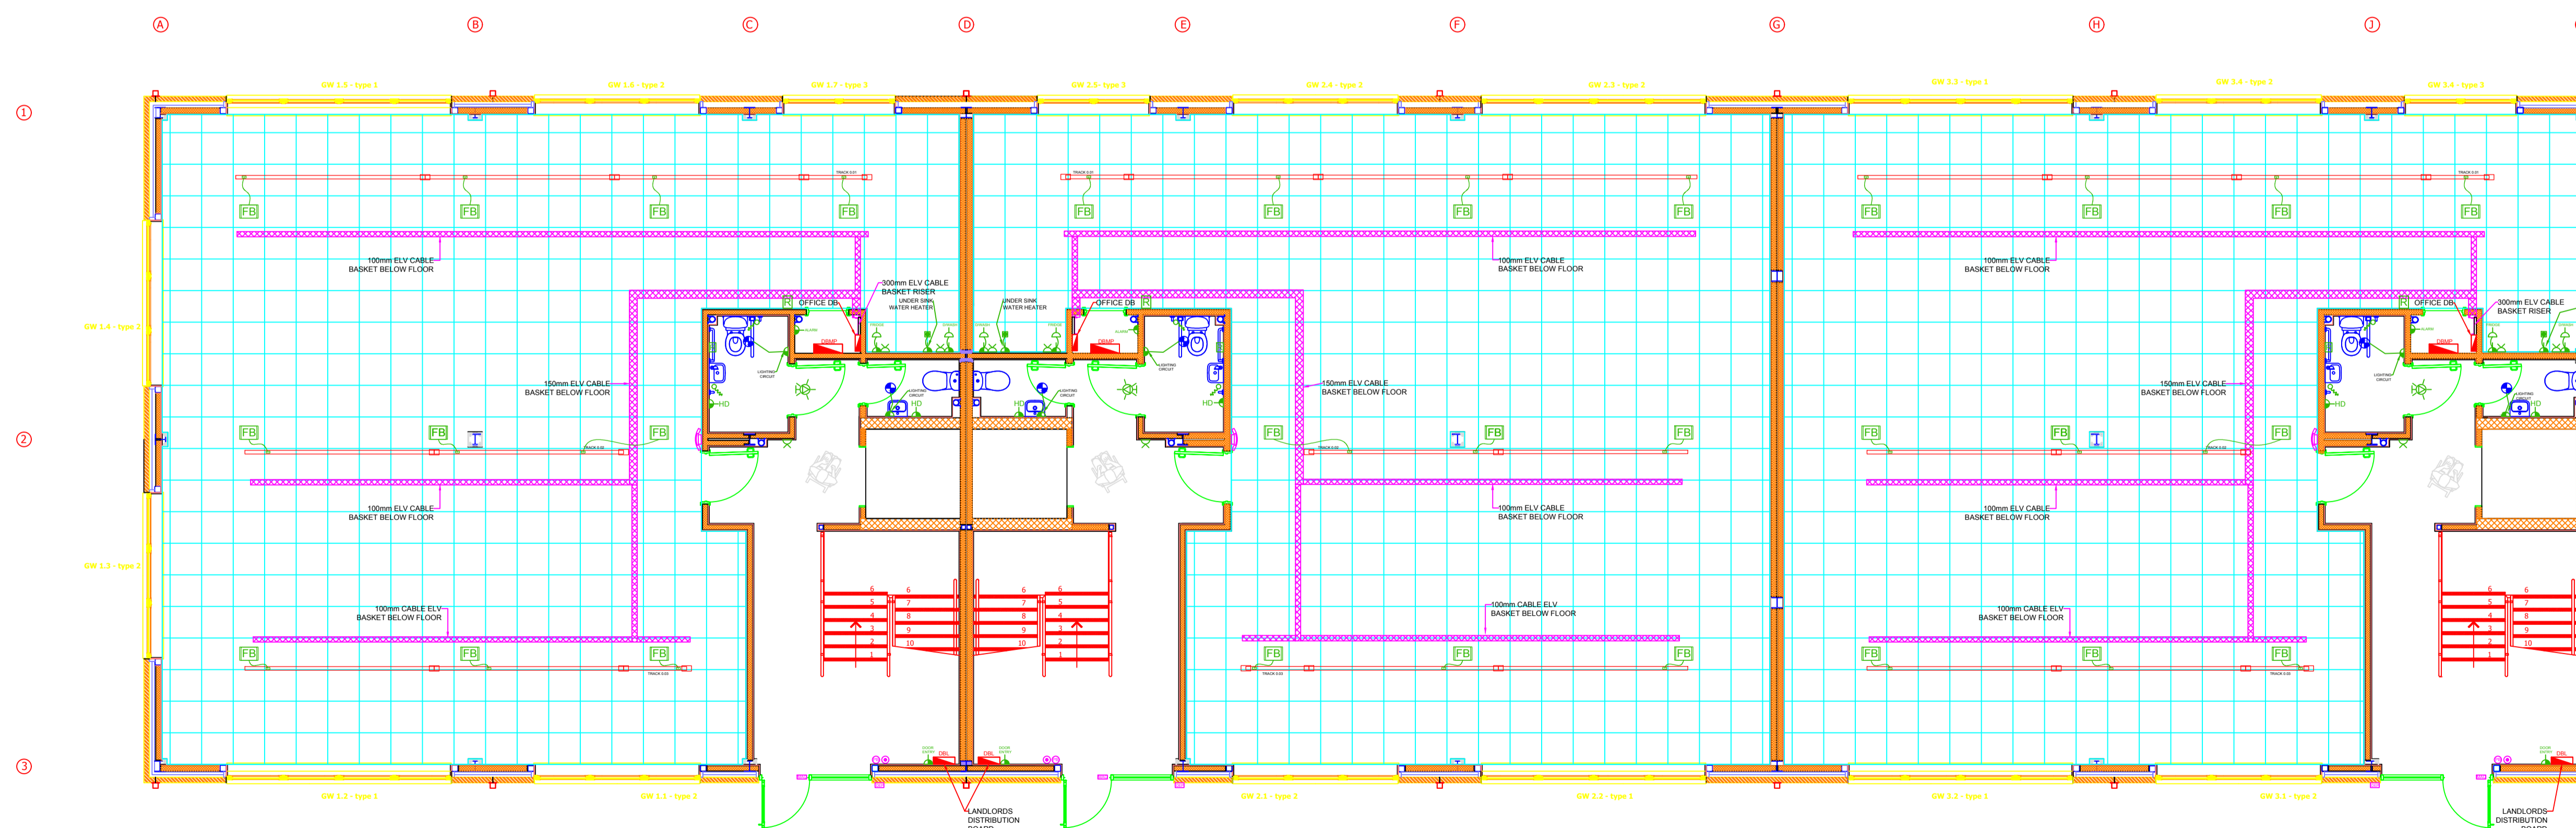

GROUND FLOOR

REV	DESCRIPTION	DATE
	REVISIONS	

**PAINEMANWARING**

Heating • Plumbing • Electrical

Unit D, Easting Trading Estate  
Dominion Way, Worthing  
West Sussex BN14 8HQ

Tel: (01903) 237522

Fax: (01903) 236511

Email: enquiries@painemanwaring.co.uk

Web: www.painemanwaring.co.uk

STATUS: RECORD DRAWING

CLIENT: W. STIRLAND

PROJECT: BLOCK B SOUTHERN GATE  
SOUTHERN SIDINGS CHICHESTER

TITLE: ELECTRICAL SERVICES  
GROUND FLOOR  
ELECTRICAL SERVICES

SCALE	DESIGNED
1:75@A1	BWL
CONTRACT NUMBER	DRAWN
EC4495	BWL
DATE	CHECKED
MAY 2017	AP
DRAWING NUMBER	REVISION
EC4105-E800	RD