




Second Floor

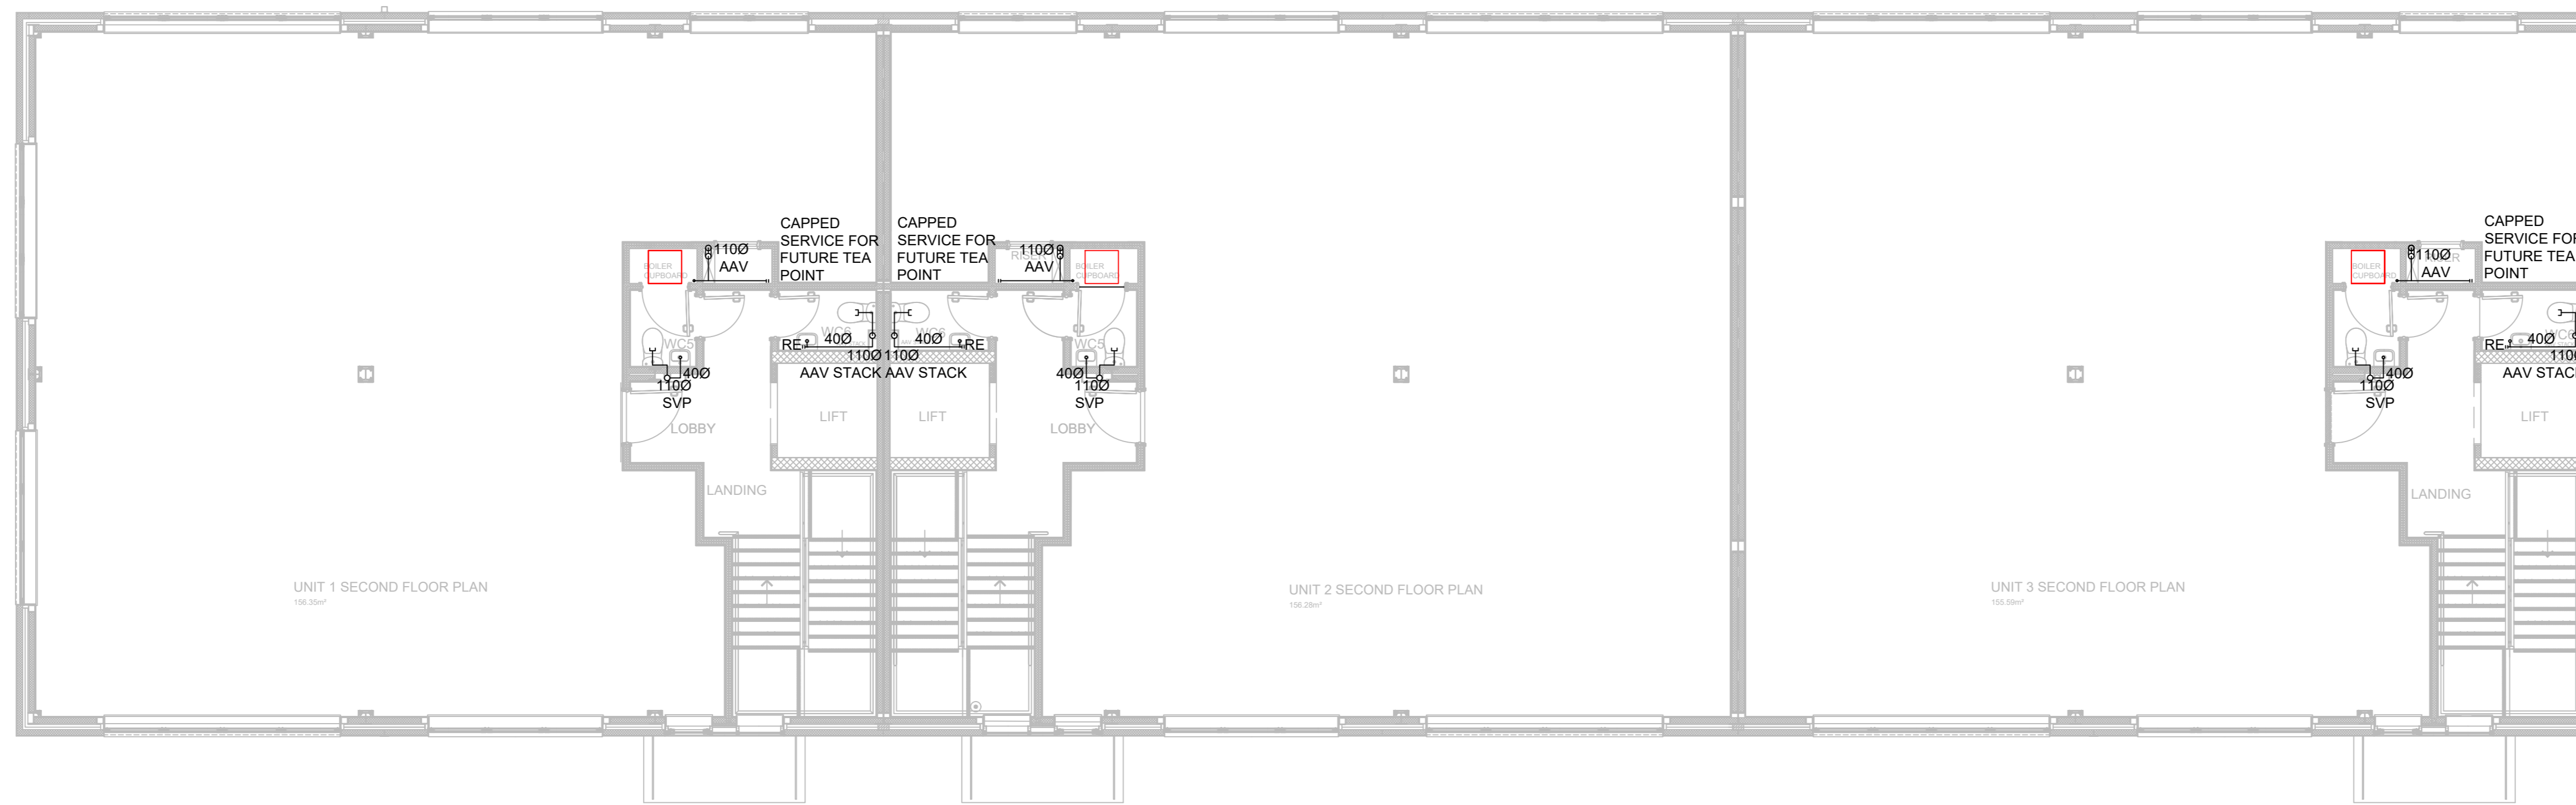

First Floor

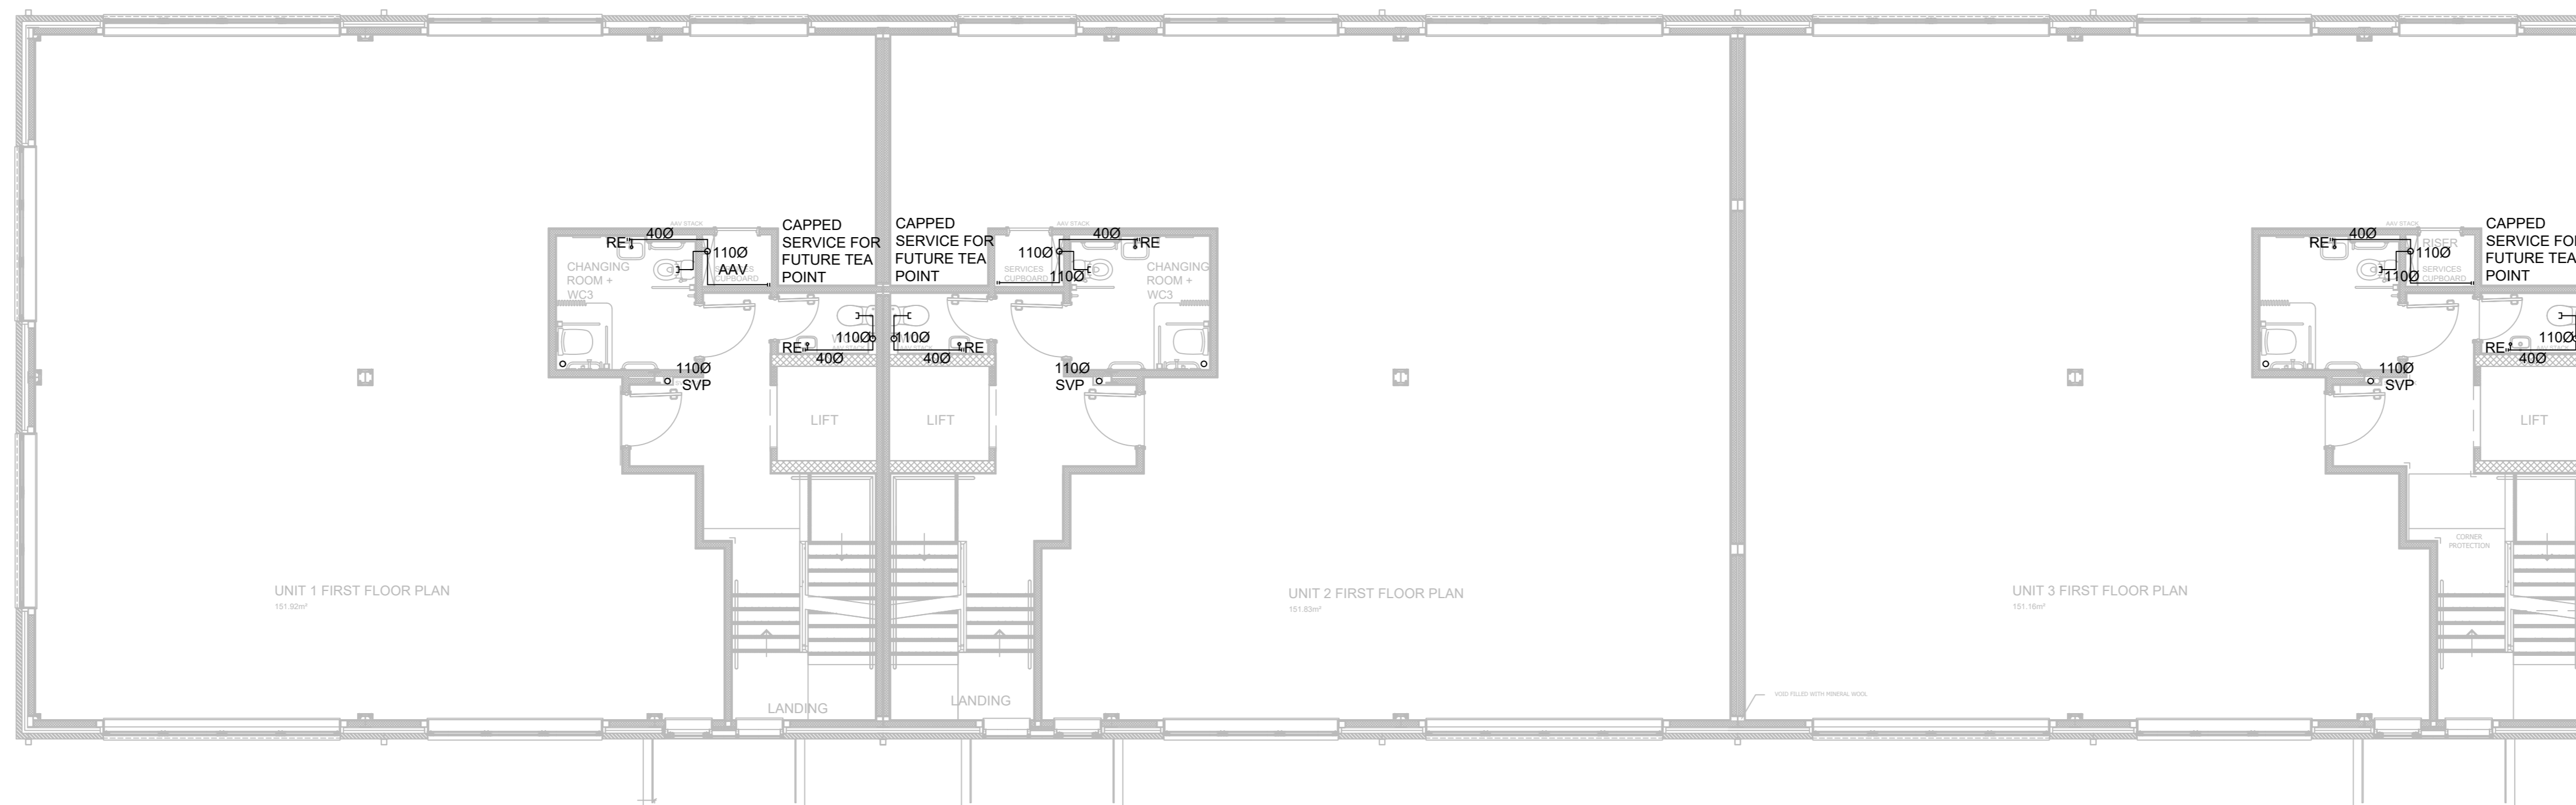

Ground Floor

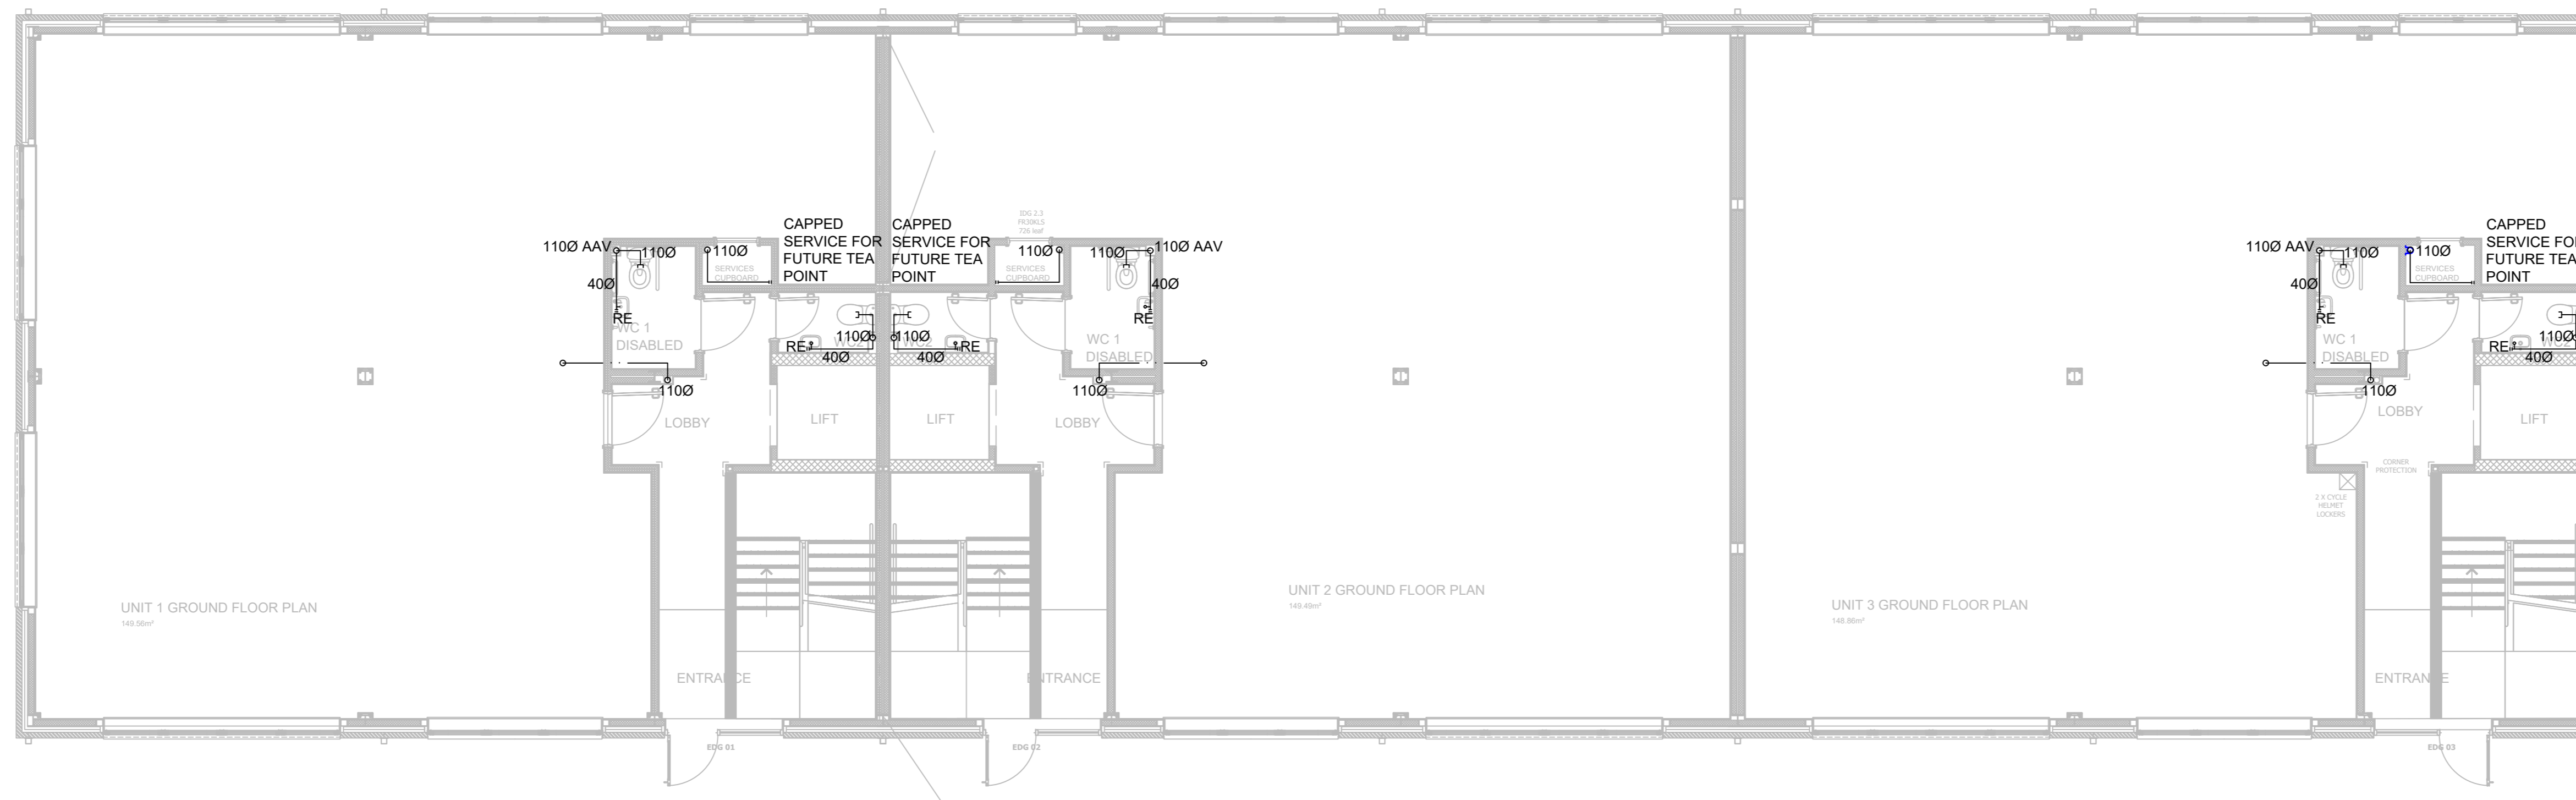

THIS DRAWING IS CONFIDENTIAL & THE COPYRIGHT OF PAINE MANWARING LTD. THE CONTENTS ARE NOT TO BE USED OR COPIED FOR ANY PURPOSE WHATSOEVER WITHOUT OUR PRIOR WRITTEN CONSENT

DO NOT SCALE
ALL DIMENSIONS IN MILLIMETRES EXCEPT WHERE OTHERWISE STATED

LEGEND:

---	PIPEWORK BELOW FLOOR IN TRENCH OR HOED
---	PIPEWORK AT LOW LEVEL
---	PIPEWORK AT HIGH LEVEL IN CEILING VOID
---	PIPEWORK AT HIGH LEVEL

NOTES:
All above ground drainage pipework to be manufactured by GSWA.
Fire Covers and wraps to be installed in line with the fire strategy drawing.
All traps to be anti-vac type.

RECORD DRAWING	DATE
CONSTRUCTION	DATE
REVISED LAYOUT	DATE
ISSUED FOR APPROVAL	DATE
DESCRIPTION	DATE
REVISIONS	DATE

PAINEMANWARING
Heating • Plumbing • Electrical
Unit D, Easting Trading Estate
Dumack Way, Hurling
West Sussex BN14 8HQ
Tel: (01903) 237522 Fax: (01903) 236511
Email: enquiries@paimanwaring.co.uk
Web: www.paimanwaring.co.uk

STATUS: RECORD DRAWING
CLIENT: W.Stirland

PROJECT: Block B Southern Gate
Southern Sidings, Chichester

TITLE: Above Ground Drainage Services

SCALE	DESIGNED
1:75@A0	CPH
CONTRACT NUMBER	DRAWN
CH035043	CPH
DATE	CHECKED
30.04.2018	MAL
DRAWING NUMBER	REVISION
M401	RD