




Second Floor

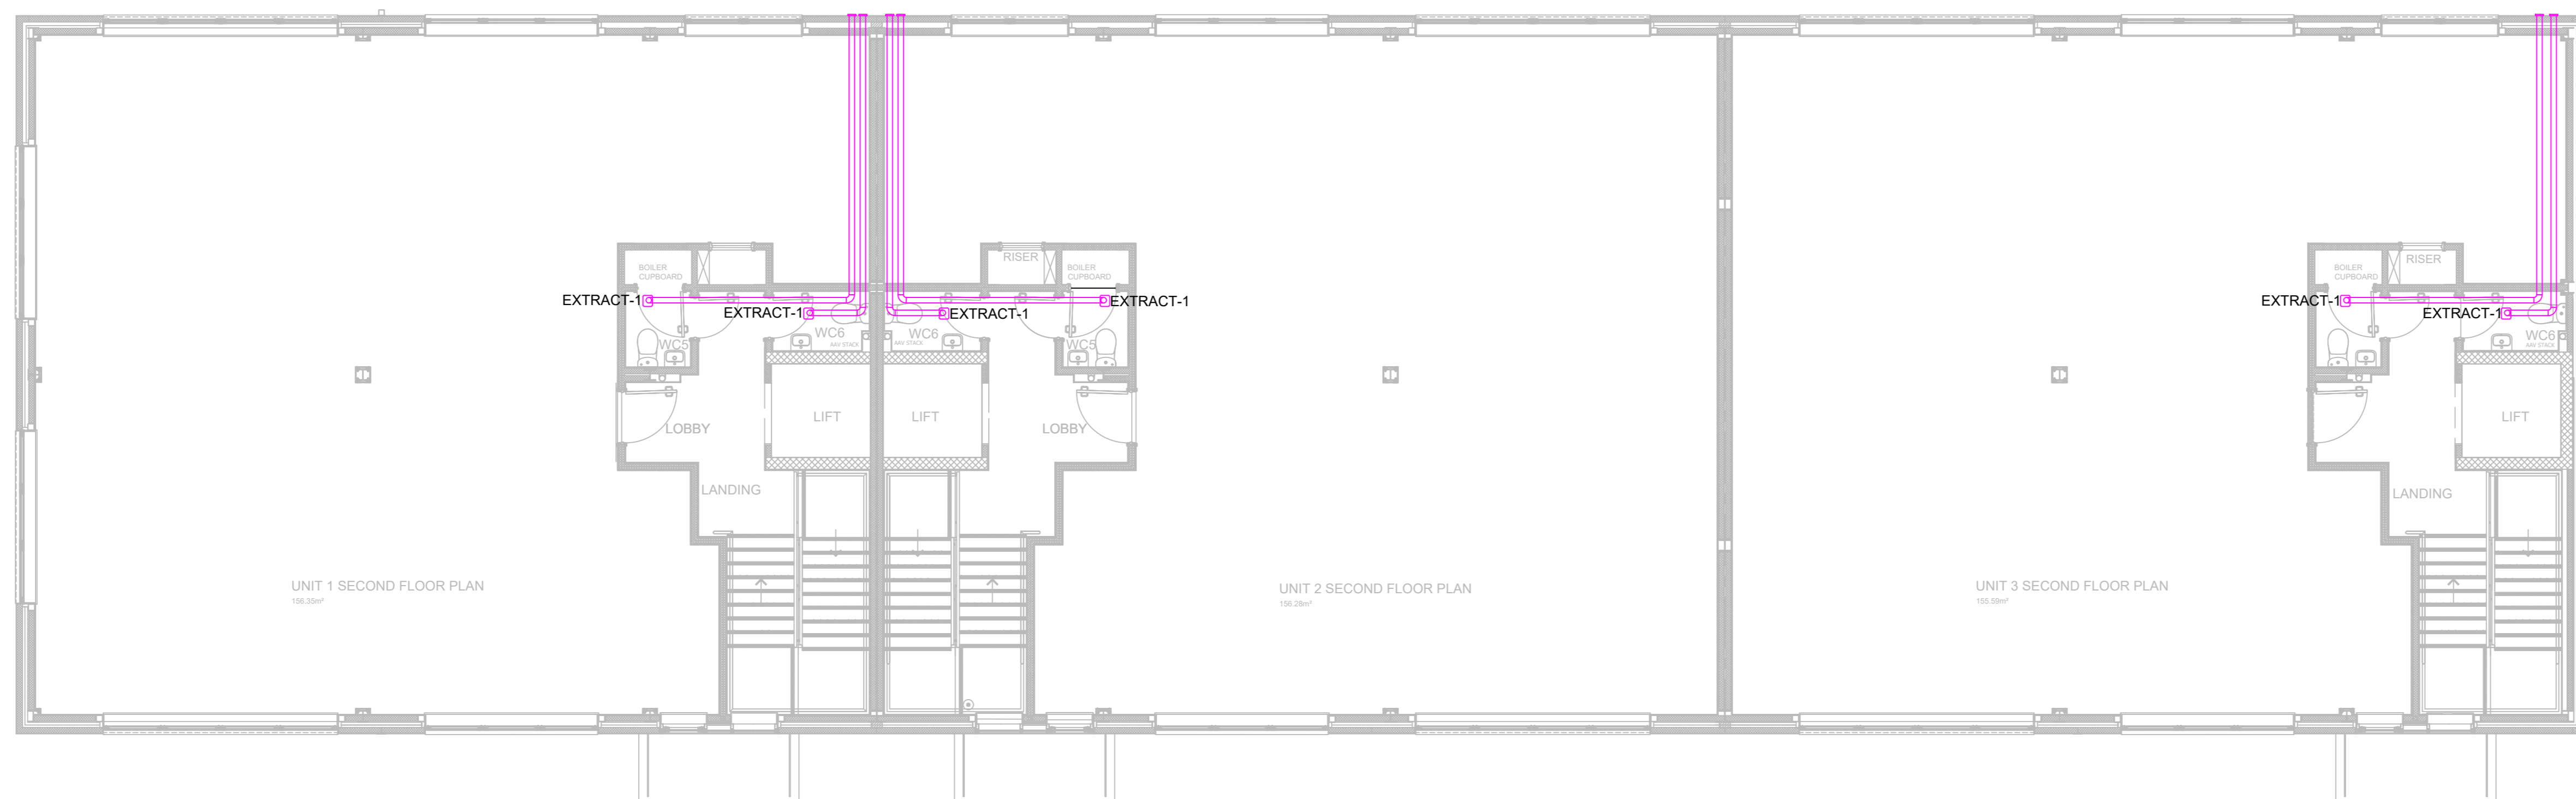

First Floor

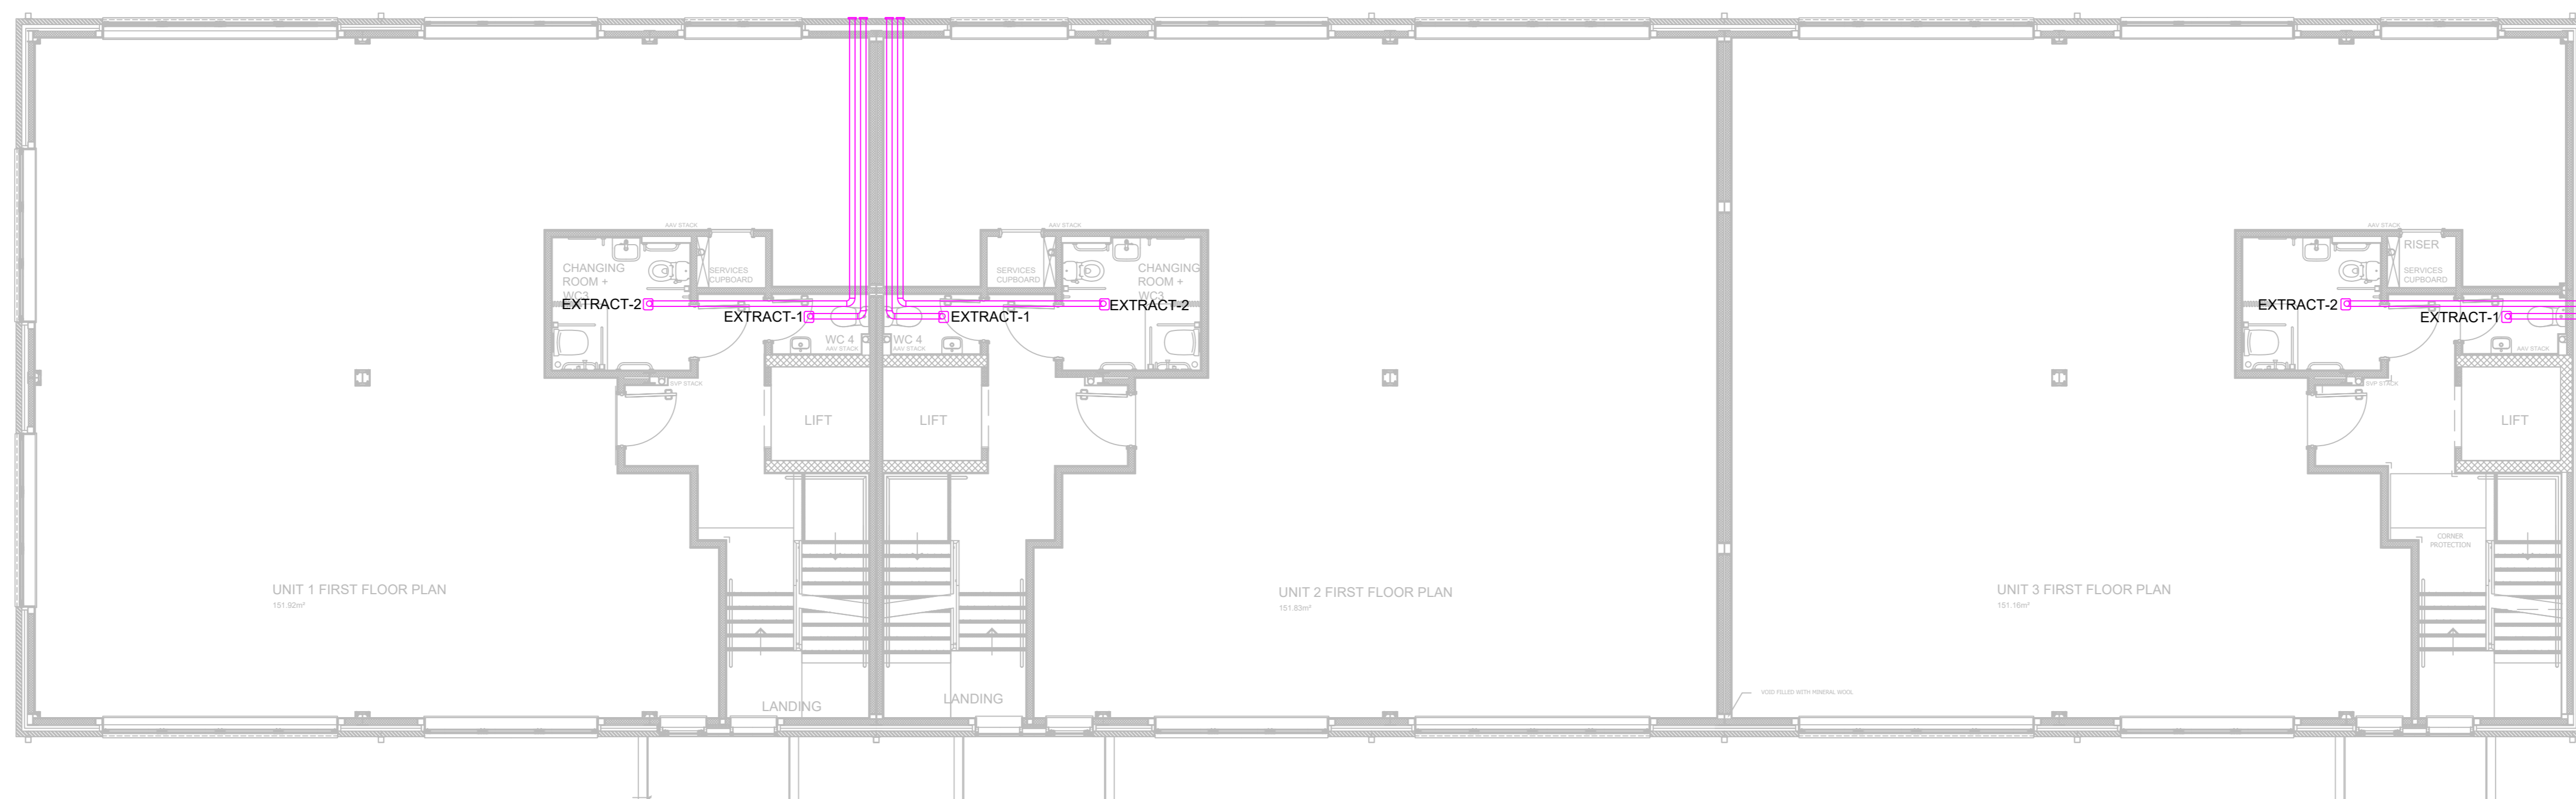

Ground Floor

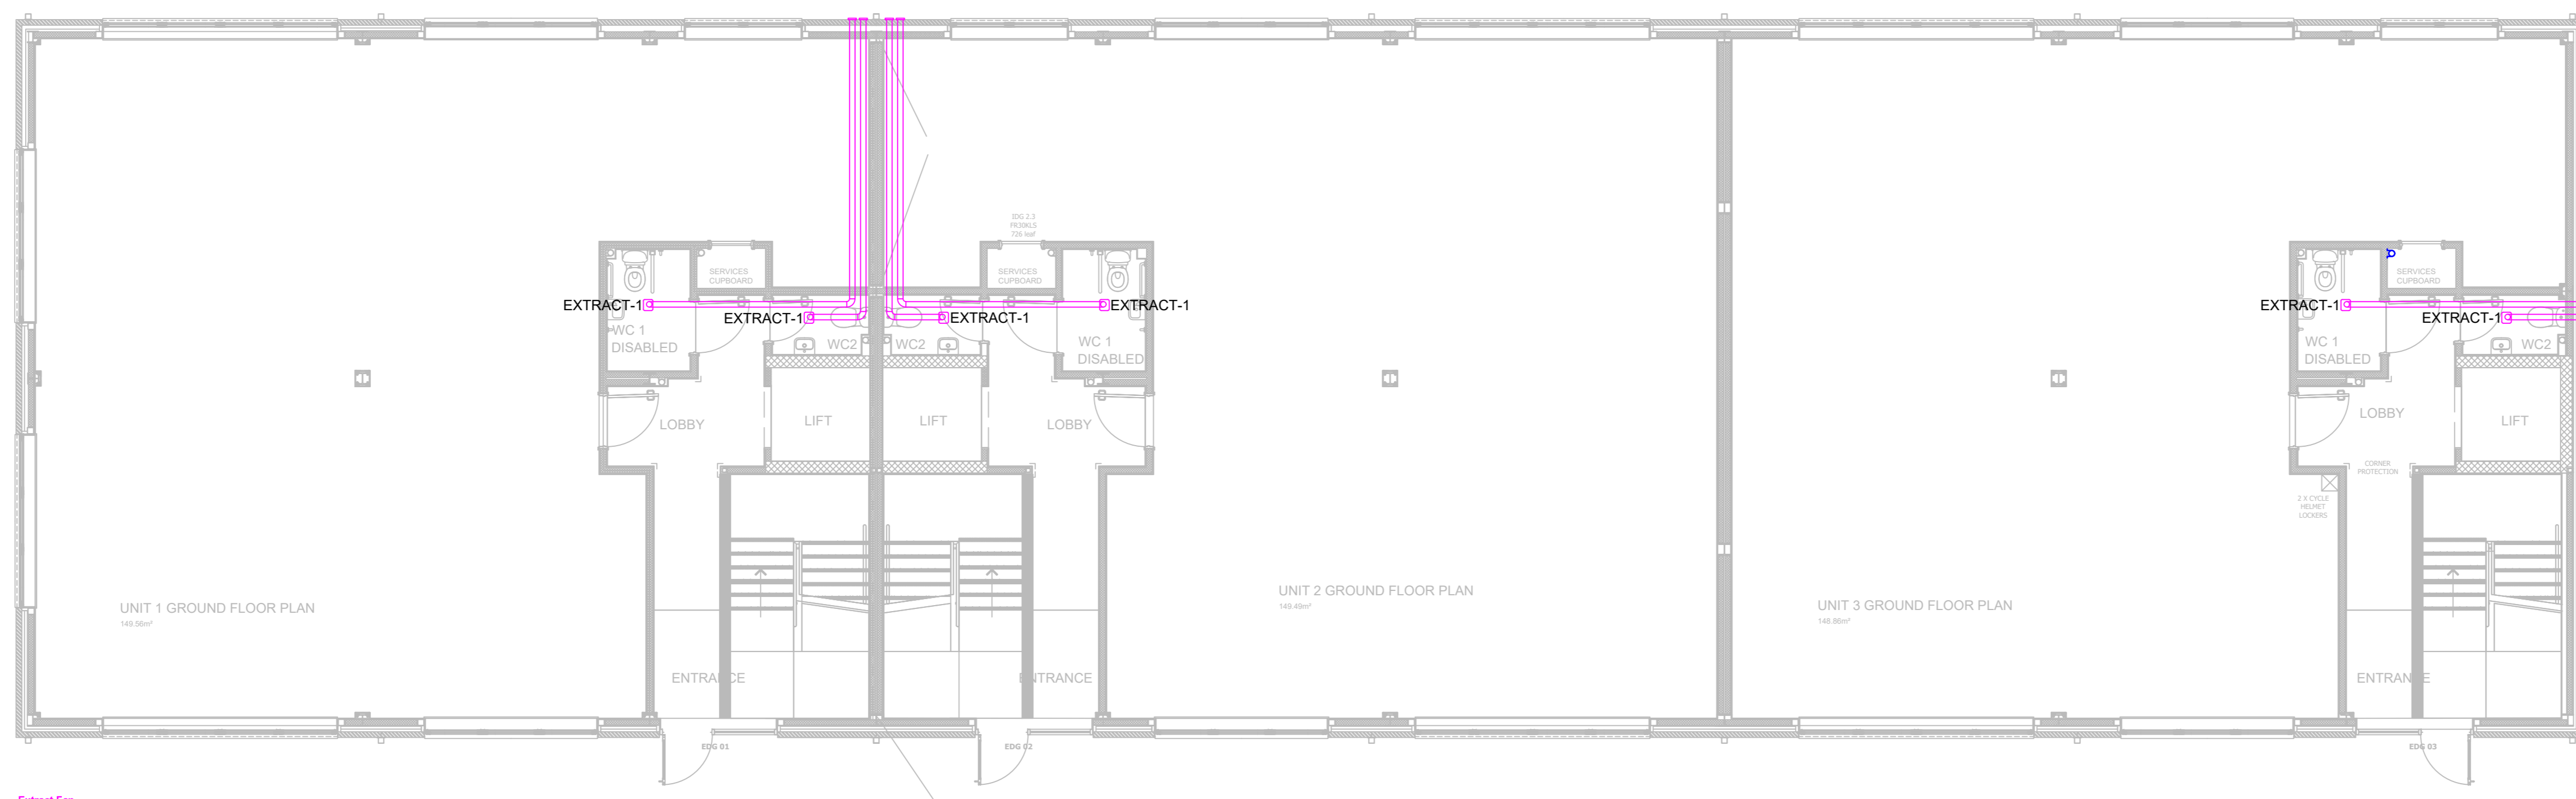

Extract Fan
 Fan Reference Manufacturer Model Control
 EXTRACT 1 Name GENE DCE Run on timer linked to lighting
 EXTRACT 2 Name GENE Run on timer linked to lighting

NOTES

All Ductwork to be 110mm/54mm flat duct

105	RECORD DRAWING	16/03/17
101	CONSTRUCTION	16/03/17
100	REVISED LAYOUT	16/03/17
101	ISSUED FOR APPROVAL	16/03/17
100	DESCRIPTION	16/03/17
100	REVISIONS	16/03/17

PAINEMANWARING
 Heating • Plumbing • Electrical

Unit D, Easting Trading Estate
 Denmark Way, Hurlingham
 West Sussex BN14 8HQ
 Tel: (01903) 237522 Fax: (01903) 236511
 Email: enquiries@paimanwaring.co.uk
 Web: www.paimanwaring.co.uk

STATUS **RECORD DRAWING**

CLIENT
W.Stirland

PROJECT
**Block B Southern Gate
 Southern Sidings, Chichester**

TITLE
Ventilation Services

SCALE	DESIGNED
1:75@A0	CPH
CONTRACT NUMBER	DRAWN
CH035043	CPH
DATE	CHECKED
30.04.2018	MAL
DRAWING NUMBER	REVISION
M301	RD