


THIS DRAWING IS CONFIDENTIAL & THE COPYRIGHT OF PAINE MANWARING LTD. THE CONTENTS ARE NOT TO BE USED OR COPIED FOR ANY PURPOSE WHATSOEVER WITHOUT OUR PRIOR WRITTEN CONSENT

DO NOT SCALE  
ALL DIMENSIONS IN MILLIMETRES EXCEPT WHERE OTHERWISE STATED

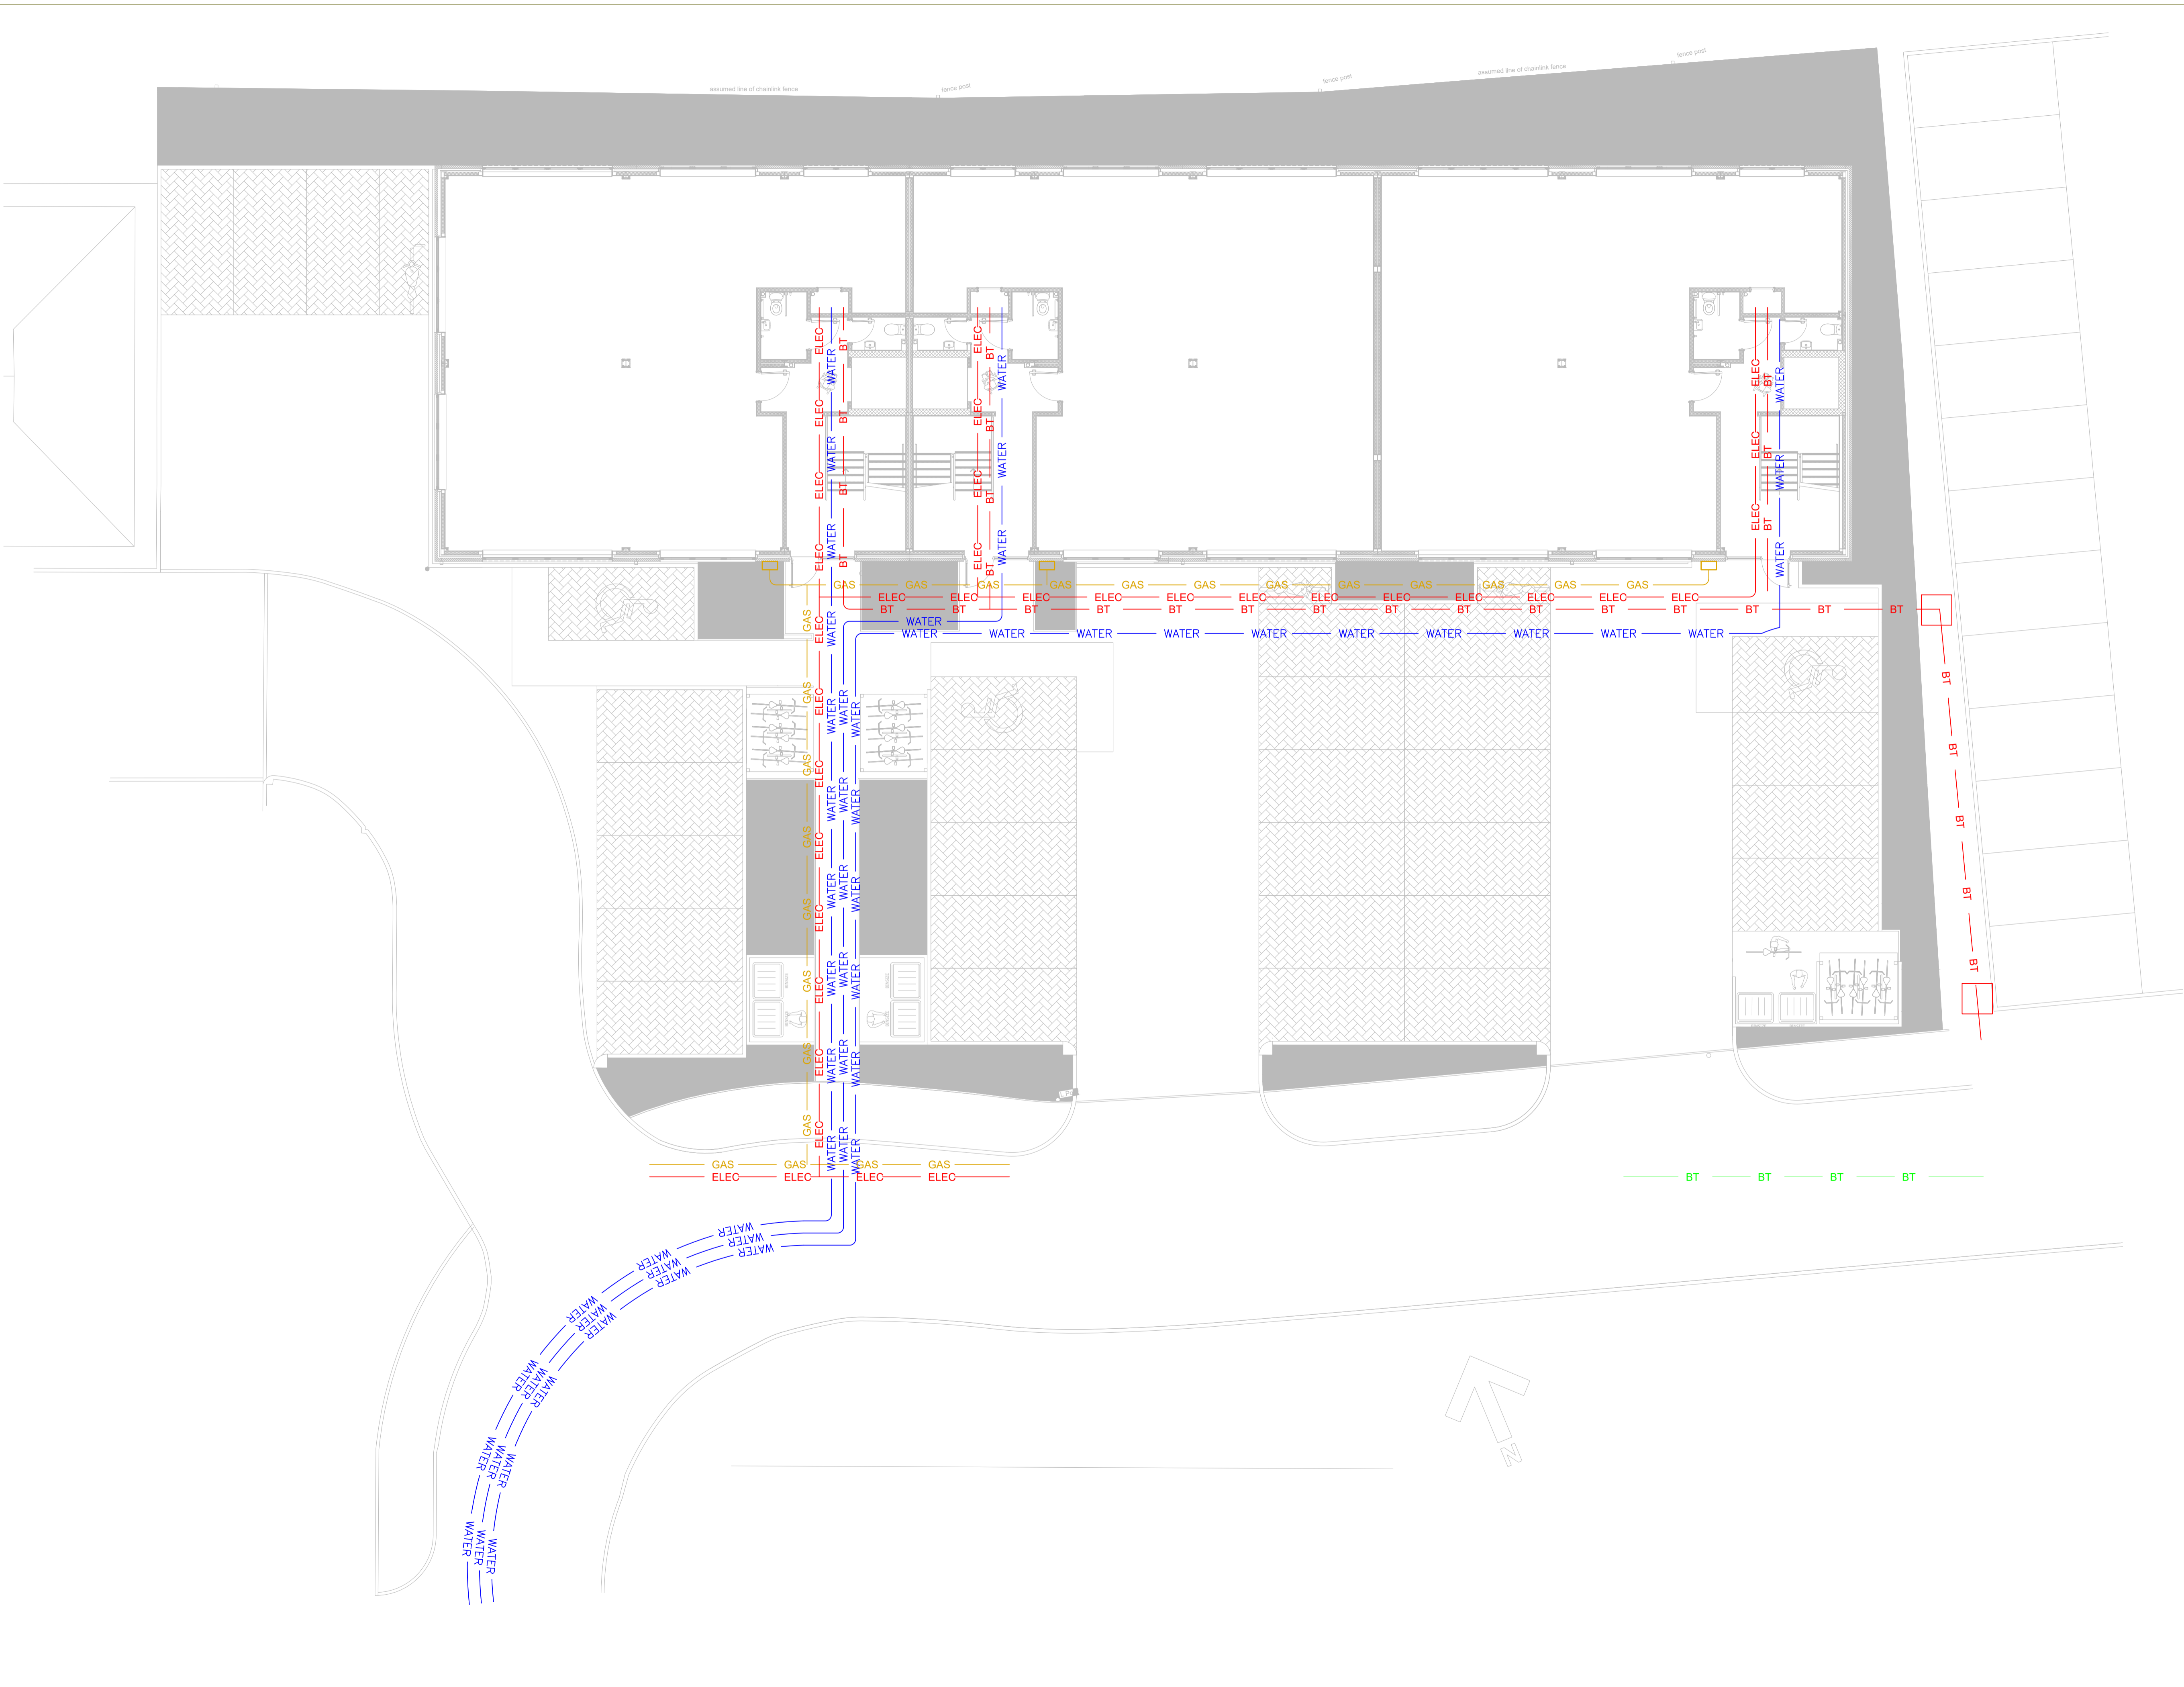

REV	NO	DESCRIPTION	DATE
		REVISIONS	

**PAINEMANWARING**  
Heating • Plumbing • Electrical

Unit D, Easting Trading Estate  
Dominion Way, Worthing  
West Sussex BN14 8HQ  
Tel (01903) 237522  
Fax (01903) 236511  
Email: enquiries@painemanwaring.co.uk  
Web: www.painemanwaring.co.uk

STATUS: RECORD DRAWING

CLIENT: W.Stirland

PROJECT: Block B Southern Gate  
Southern Sidings, Chichester

TITLE: External Services

SCALE: 1:100@A1	DESIGNED: CPH
CONTRACT NUMBER: CH035043	DRAWN: CPH
DATE: 30.04.2018	CHECKED: MAL
DRAWING NUMBER: M800	REVISION: RD