
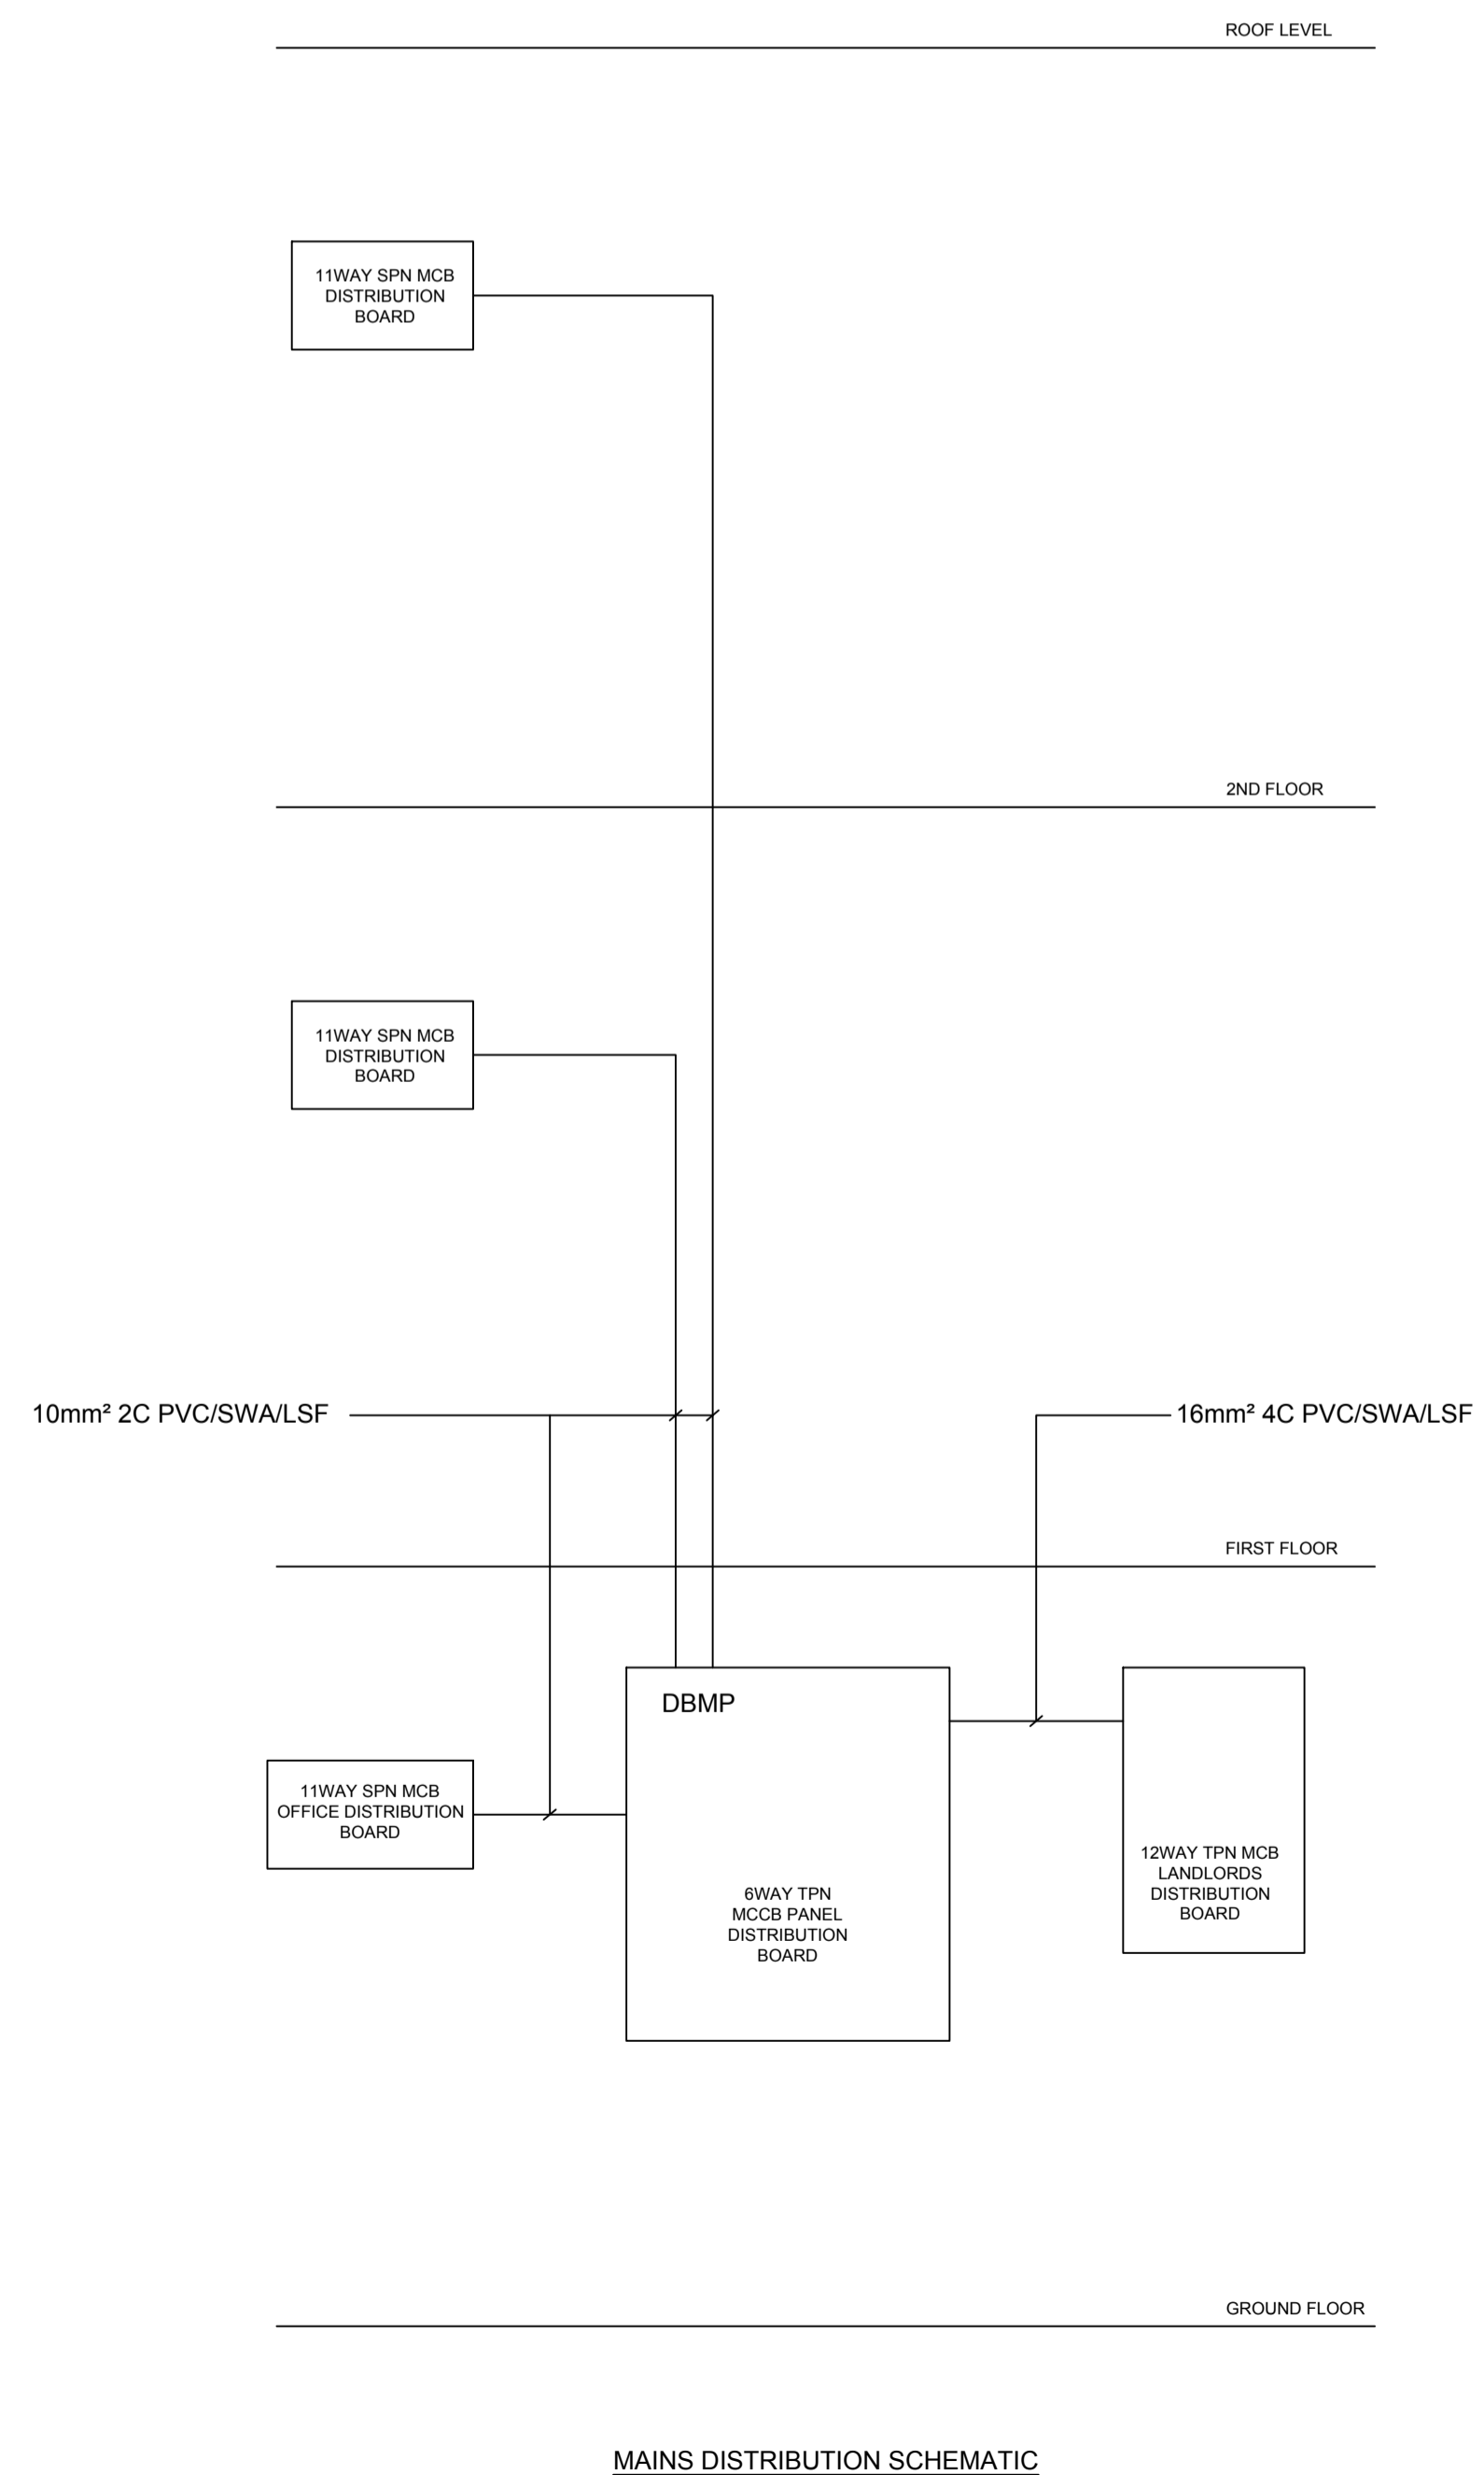


- A** THORN LIGHTING BETA OFFICE LED3400-840 HF Q597 600X600 LED RECESSED MODULAR UGR<19 3129 LUMENS 34.4W 96644029
- AE** THORN LIGHTING BETA OFFICE LED3400-840 HF E3 Q597 600X600 LED RECESSED MODULAR UGR<19 3129 LUMENS 34.4W C/W 3HR EMERGENCY 96644035
- B** THORN LIGHTING CHALICE CHAL 200 LED2000-840 HF RSB CIRCULAR RECESSED LED DOWN LIGHT 1900 LUMENS 18.5W 96642305
- BE** THORN LIGHTING CHALICE CHAL 200 LED2000-840 HF E3 RSB CIRCULAR RECESSED LED DOWN LIGHT 1900 LUMENS 18.5W C/W 3HR EMERGENCY 96642317
- C** THORN LIGHTING CHALICE CHAL 200 LED1300-840 HF RSB CIRCULAR RECESSED LED DOWN LIGHT 1900 LUMENS 18.5W 96642303
- CE** THORN LIGHTING CHALICE CHAL 200 LED1300-840 HF E3 RSB CIRCULAR RECESSED LED DOWN LIGHT 1900 LUMENS 18.5W C/W 3HR EMERGENCY
- DE** THORN LIGHTING NOVALINE LED2500-840 HF E3 WH SURFACE CIRCULAR BULKHEAD WHITE 2500 LUMENS 22.5W C/W 3HR EMERGENCY 96642698
- F** ANSELL BETA LED ABELED/MW CIRCULAR SURFACE GENERAL PURPOSE LED BULKHEAD 430 LUMENS 5W
- DE** THORN LIGHTING EYE VIS 700 LEDHF OP S L840 SURFACE MOUNTED EXTERNAL WALL MOUNTED 12W C/W 3HR EMERGENCY 96210401
- THORN LIGHTING VOYAGER VYBLMR BLADE EXIT SIGN E3M MRE SLIM CEILING MOUNTED EXIT SIGN

- MAINS DISTRIBUTION BOARD
- 2 GANG SWITCHED SOCKET OUTLET
- 1 GANG SWITCHED SOCKET OUTLET
- SWITCHED FUSED SPUR
- UNSWITCHED FUSED SPUR
- 20A DP SWITCH
- ISOLATOR SPN
- ISOLATOR TPN
- COMMANDO SOCKET
- MASTERSEAL SPLASH RESISTANT TWIN SOCKET
- CONNECTION POINT
- KEY RELEASED KNOCK OFF/STOP BUTTONS
- TELEPHONE/DATA OUTLET TWIN
- FLOOR BOX, 2No TWIN SOCKET & 4G DATA
- HAND DRYER (PROVISION ONLY)
- HIGH LEVEL
- SURFACE MOUNTED
- ROOM STAT/SENSOR MOUNTED @ 1500mm AFFL
- DISABLED WC ALARM PULLCORD
- DISABLED WC ALARM RESET UNIT
- DISABLED WC ALARM OVER DOOR INDICATOR
- LOCAL EXTRACT FAN (BY MECHANICAL)
- MAGNETIC DOOR HOLDER
- PROXIMITY READER
- VIDEO DOOR ENTRY PANEL
- PUSH BUTTON RELEASE
- GREEN BREAK GLASS RELEASE
- DOOR ENTRY HANDSET

- KEY OPERATED SWITCHED FUSED SPUR AS MK K963KOALM
- SMOKE DETECTOR
- BEACON UNIT
- WITHIN CEILING VOID
- CALL POINT
- FIRE ALARM PANEL
- ELECTRONIC SOUNDER
- INPUT/OUTPUT UNIT
- DISABLED PERSON REFUGE ALARM/INTERCOM

- 1 way Light Switch
- 2 way Light Switch
- Retractive Switch
- Intermediate Light Switch
- Fan Isolator Switch
- External Photo cell
- CP Electronics EBDSPiR-PRM Stand alone Flush ceiling mounted presence detector
- CP ELECTRONICS VITESSE MODULAR LIGHTING CONTROL MODULE
- CP ELECTRONICS MWS3A ADJUSTABLE CEILING MOUNTED MICROWAVE PRESENCE/ABSENCE DETECTOR FOR USE WITH THE VITESSE LCM
- CP ELECTRONICS EBDSPiR ADJUSTABLE CEILING MOUNTED MICROWAVE PRESENCE/ABSENCE DETECTOR FOR USE WITH THE VITESSE LCM

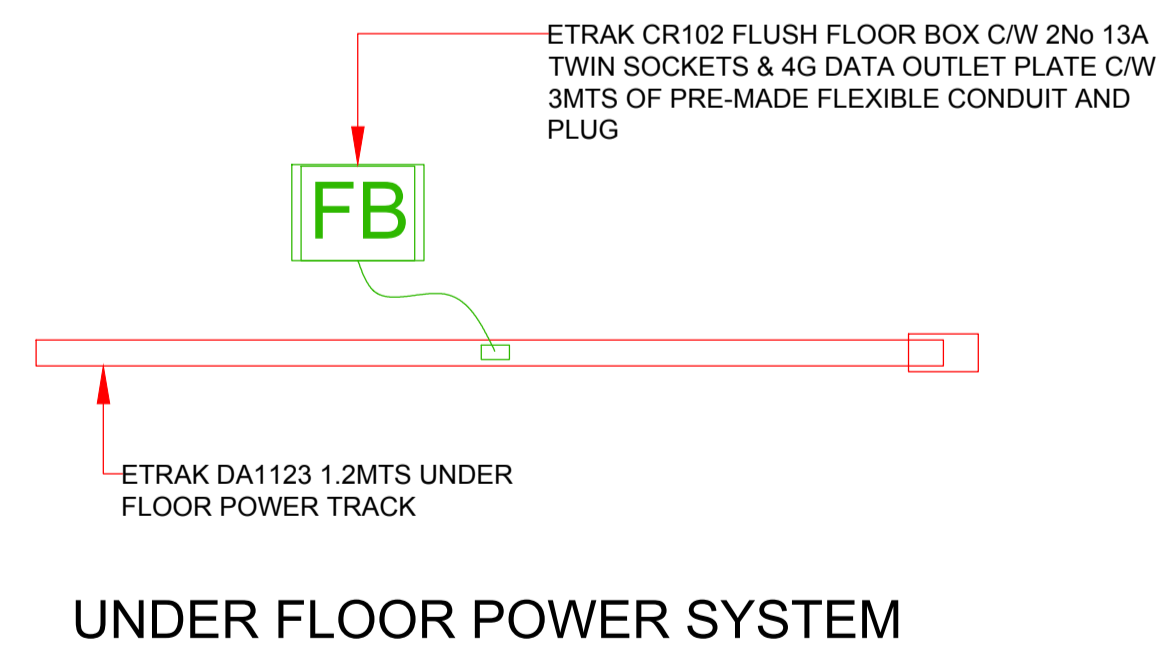

REV	DESCRIPTION	DATE

**PAINEMANWARING**  
Heating • Plumbing • Electrical  
Unit D, Easting Trading Estate  
Dominion Way, Worthing  
West Sussex BN14 8HQ  
Tel: (01903) 237522  
Fax: (01903) 236511  
Email: enquiries@painemanwaring.co.uk  
Web: www.painemanwaring.co.uk

STATUS: **RECORD DRAWING**

CLIENT: **W.STIRLAND**

PROJECT: **BLOCK B SOUTHERN GATE SOUTHERN SIDINGS CHICHESTER**

TITLE: **ELECTRICAL SERVICES LEGEND AND LIGHTING SCHEDULE**

SCALE	DESIGNED
1:75@A1	BWL
CONTRACT NUMBER	DRAWN
EC4495	BWL
DATE	CHECKED
MAY 2017	AP
DRAWING NUMBER	REVISION
EC4105-E001	RD