


THIS DRAWING IS CONFIDENTIAL & THE COPYRIGHT OF PAINE MANWARING LTD. THE CONTENTS ARE NOT TO BE USED OR COPIED FOR ANY PURPOSE WHATSOEVER WITHOUT OUR PRIOR WRITTEN CONSENT

DO NOT SCALE

ALL DIMENSIONS IN MILLIMETRES EXCEPT WHERE OTHERWISE STATED

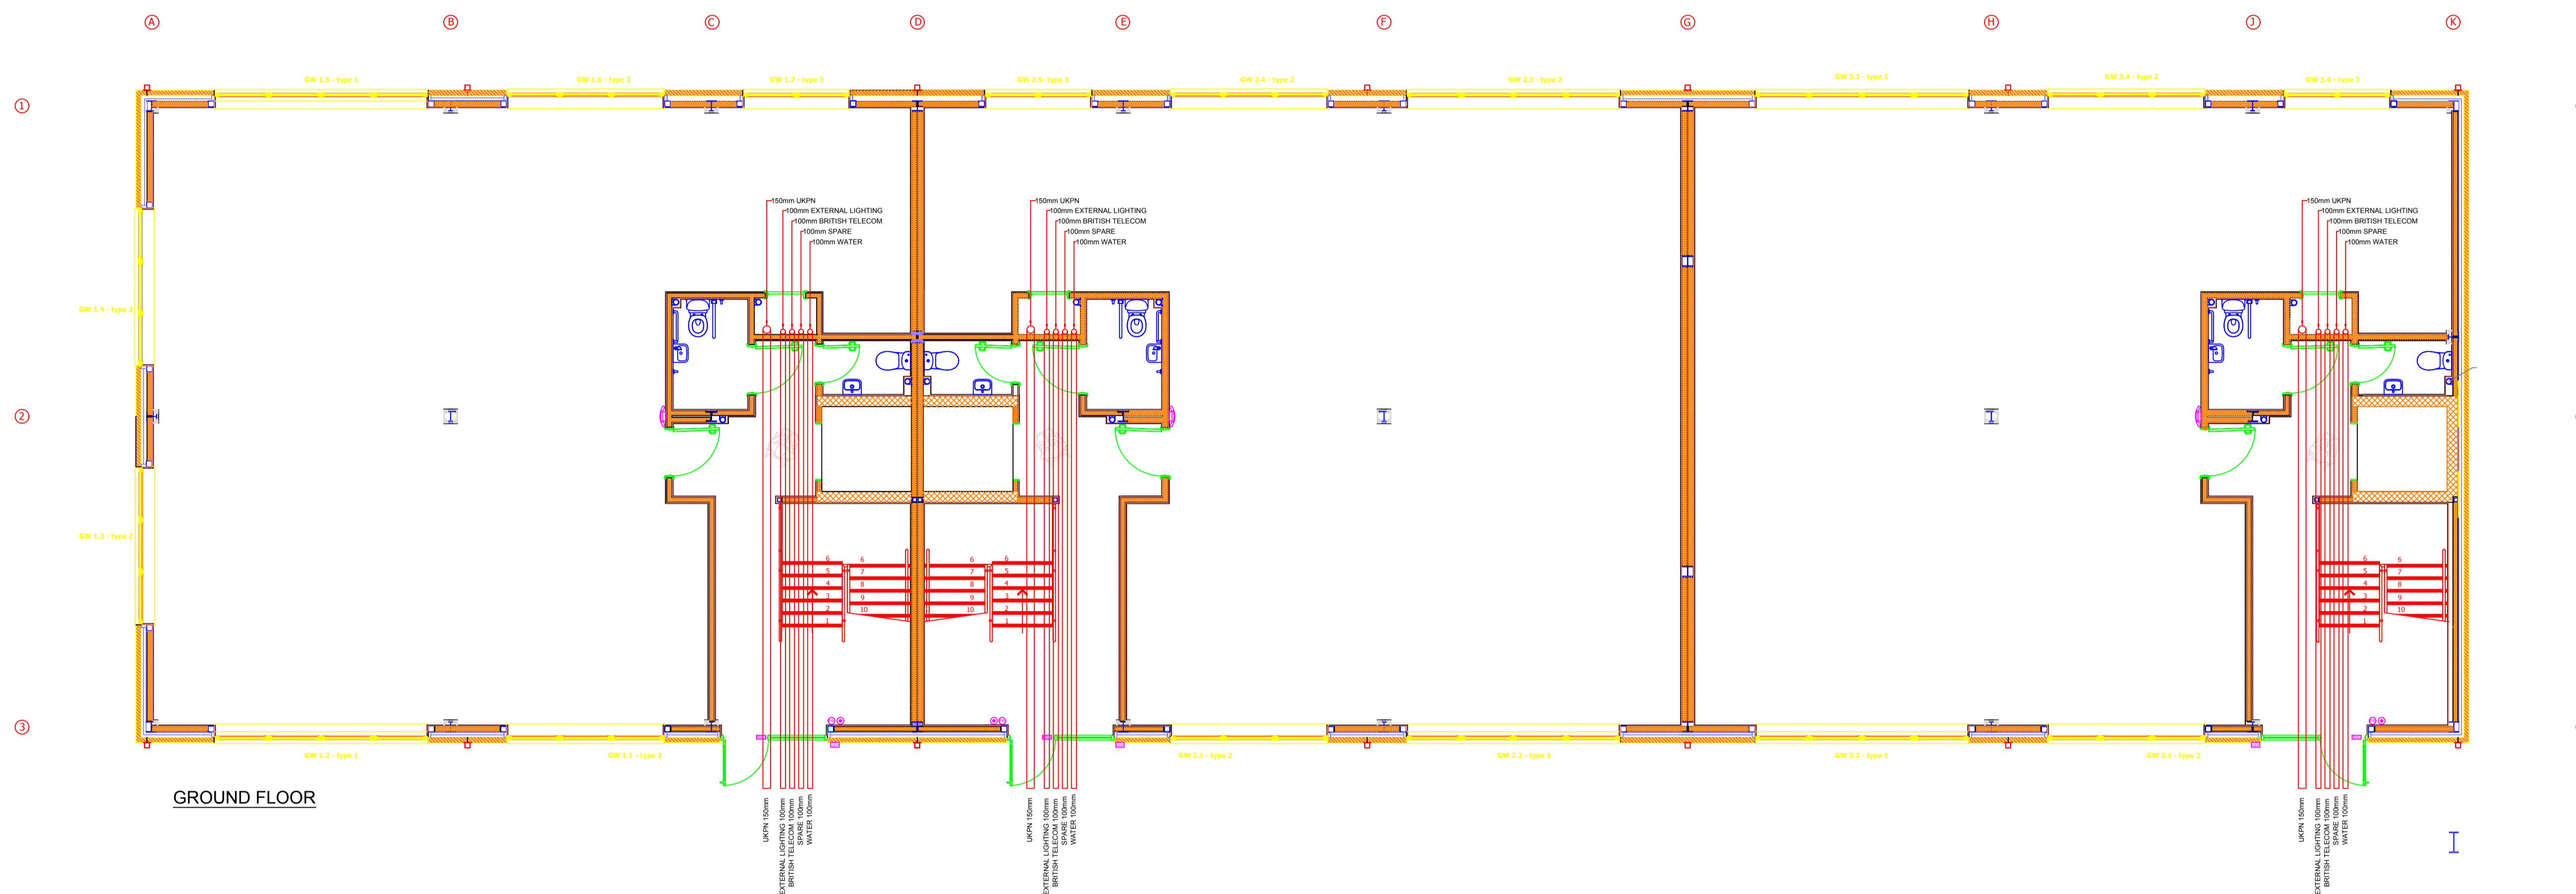

GROUND FLOOR

REV	DESCRIPTION	DATE

PAINEMANWARING
Heating • Plumbing • Electrical

Unit D, Easting Trading Estate
Dominion Way, Worthing
West Sussex BN14 8HQ

Tel: (01903) 237522
Fax: (01903) 236511
Email: enquiries@painemanwaring.co.uk
Web: www.painemanwaring.co.uk

STATUS
RECORD DRAWING

CLIENT
W.STIRLAND

PROJECT
**BLOCK B SOUTHERN GATE
SOUTHERN SIDINGS CHICHESTER**

TITLE
**ELECTRICAL SERVICES
GROUND FLOOR
INCOMING SERVICES DUCTING**

SCALE	DESIGNED
1:75@A1	BWL
CONTRACT NUMBER	DRAWN
EC4495	BWL
DATE	CHECKED
MAY 2017	AP
DRAWING NUMBER	REVISION
EC4105-E500	RD