



THIS DRAWING IS CONFIDENTIAL & THE COPYRIGHT OF PAINE MANWARING LTD. THE CONTENTS ARE NOT TO BE USED OR COPIED FOR ANY PURPOSE WHATSOEVER WITHOUT OUR PRIOR WRITTEN CONSENT

DO NOT SCALE

ALL DIMENSIONS IN MILLIMETRES EXCEPT WHERE OTHERWISE STATED

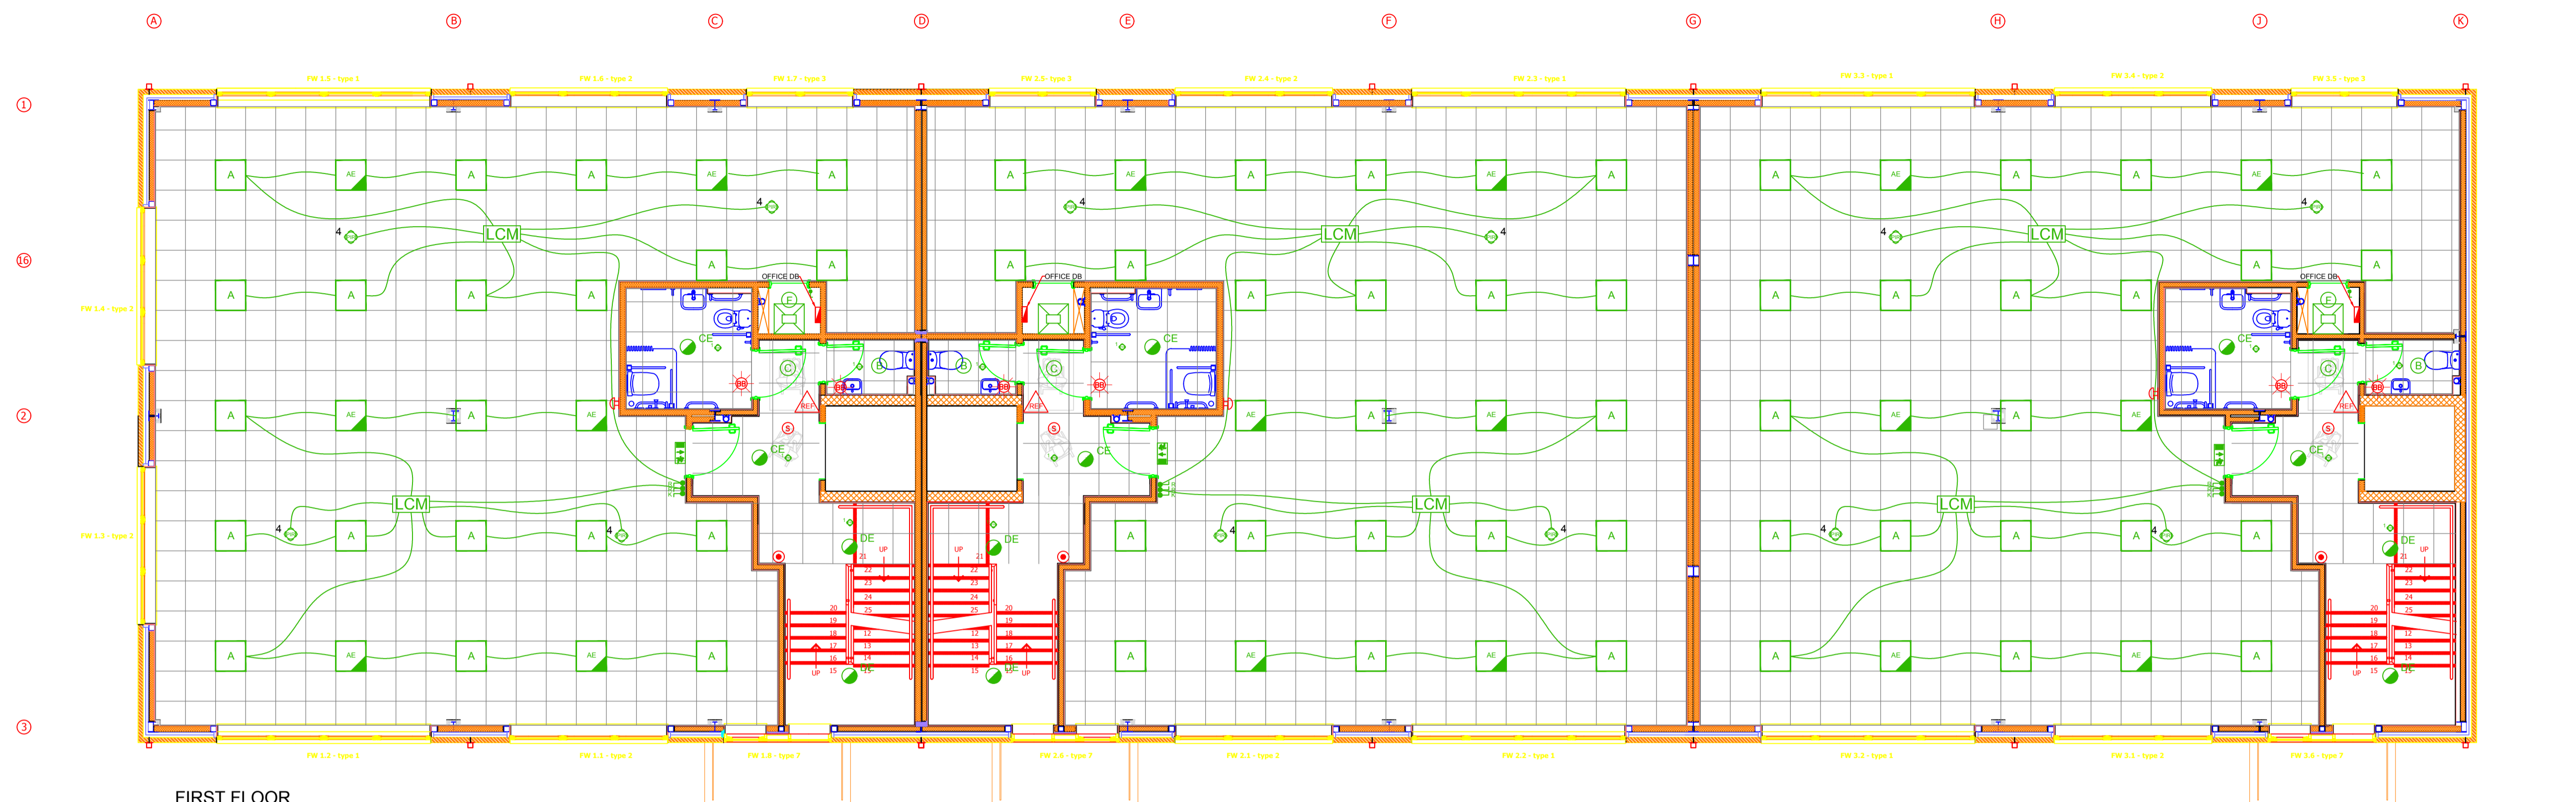

FIRST FLOOR

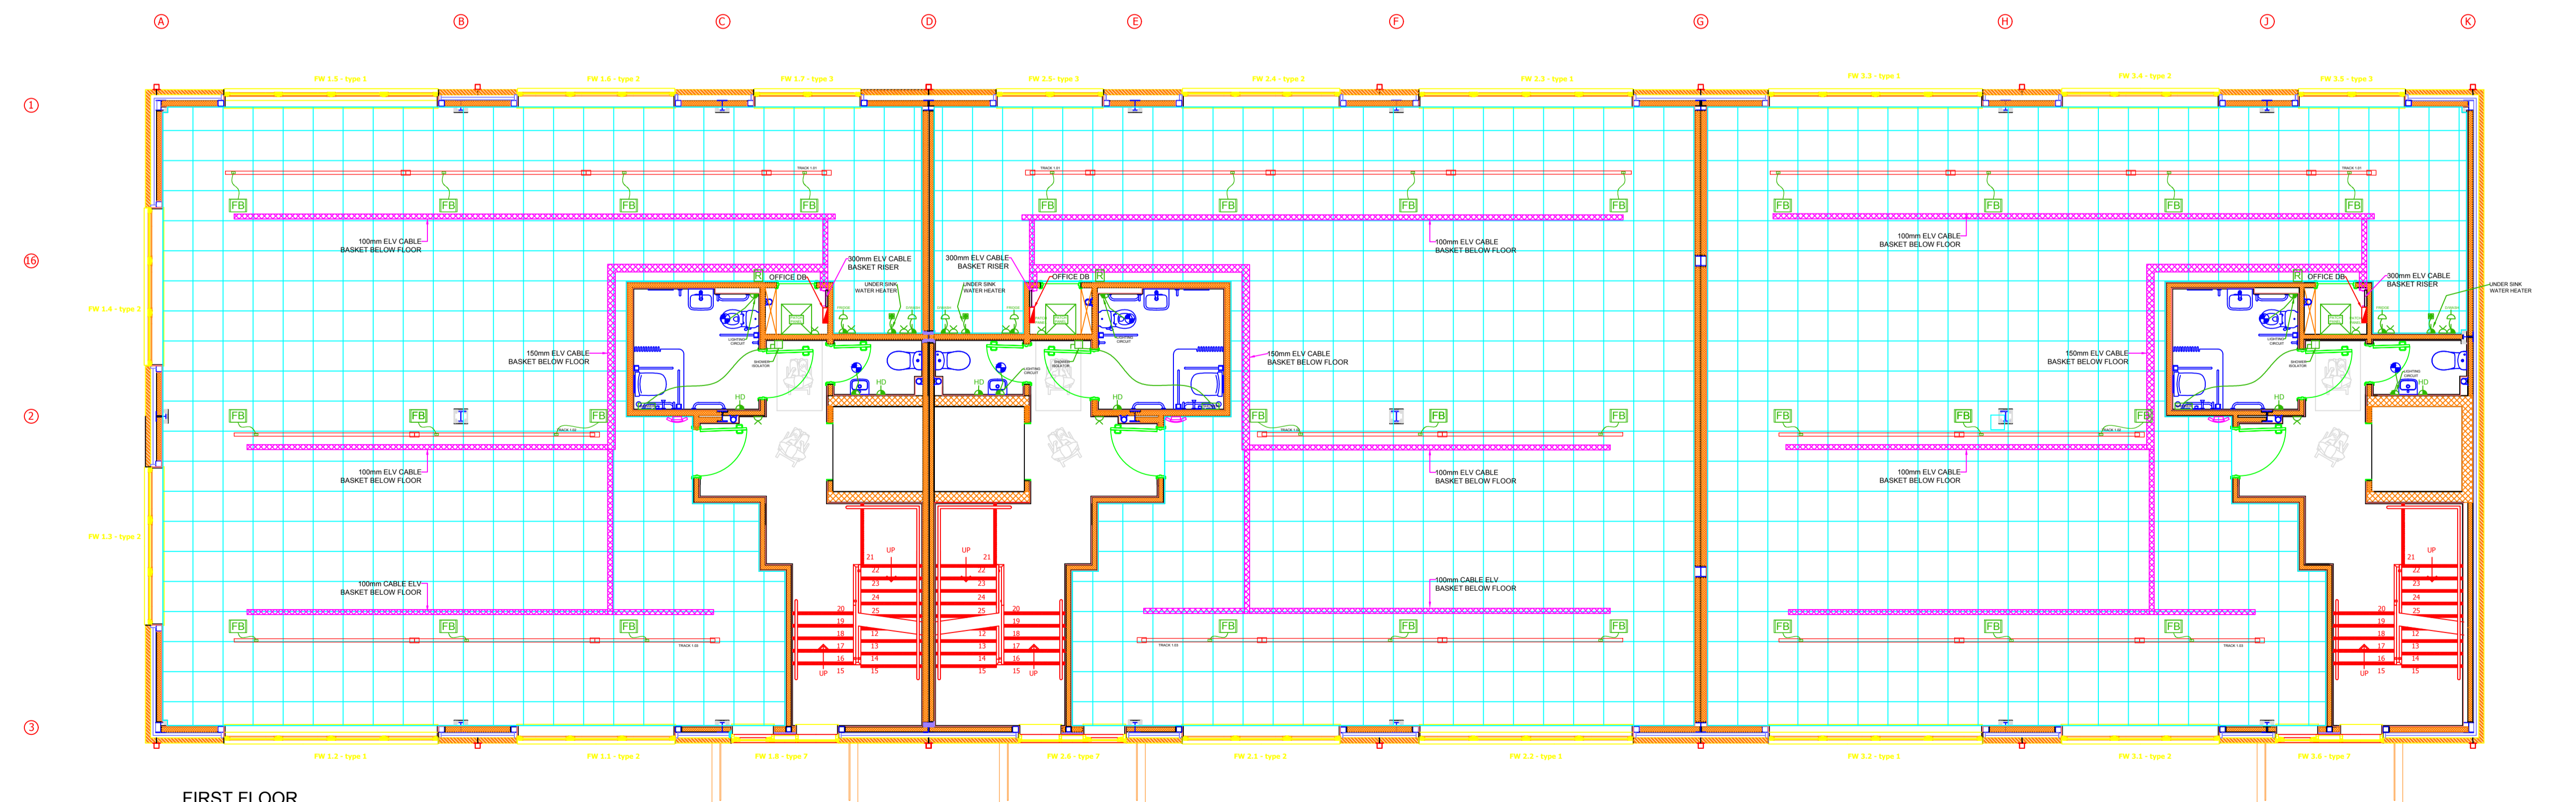

FIRST FLOOR

REV	DESCRIPTION	DATE

PAINEMANWARING
 Heating • Plumbing • Electrical
 Unit D, Easting Trading Estate
 Dominion Way, Worthing
 West Sussex BN14 8HQ
 Tel: (01903) 237522
 Fax: (01903) 236511
 Email: enquiries@paimanwaring.co.uk
 Web: www.paimanwaring.co.uk

STATUS
RECORD DRAWING

CLIENT
W.STIRLAND

PROJECT
**BLOCK B SOUTHERN GATE
 SOUTHERN SIDINGS CHICHESTER**

TITLE
**ELECTRICAL SERVICES
 FIRST FLOOR
 ELECTRICAL SERVICES**

SCALE 1:75@A1	DESIGNED BWL
CONTRACT NUMBER EC4495	DRAWN BWL
DATE MAY 2017	CHECKED AP
DRAWING NUMBER EC4105-E801	REVISION RD