


DESIGNERS RISK ASSESSMENT

Significant or unusual / "not obvious" residual risks during construction, use & demolition to be recorded below.
Note: Design Risk Assessment & Appointment of Principle Designer forms to be produced if works are to last longer than 30 days and have more than 20 workers working simultaneously at any point in the project OR works exceed 500 person days to use

Risk: Mitigating Measure: Date:

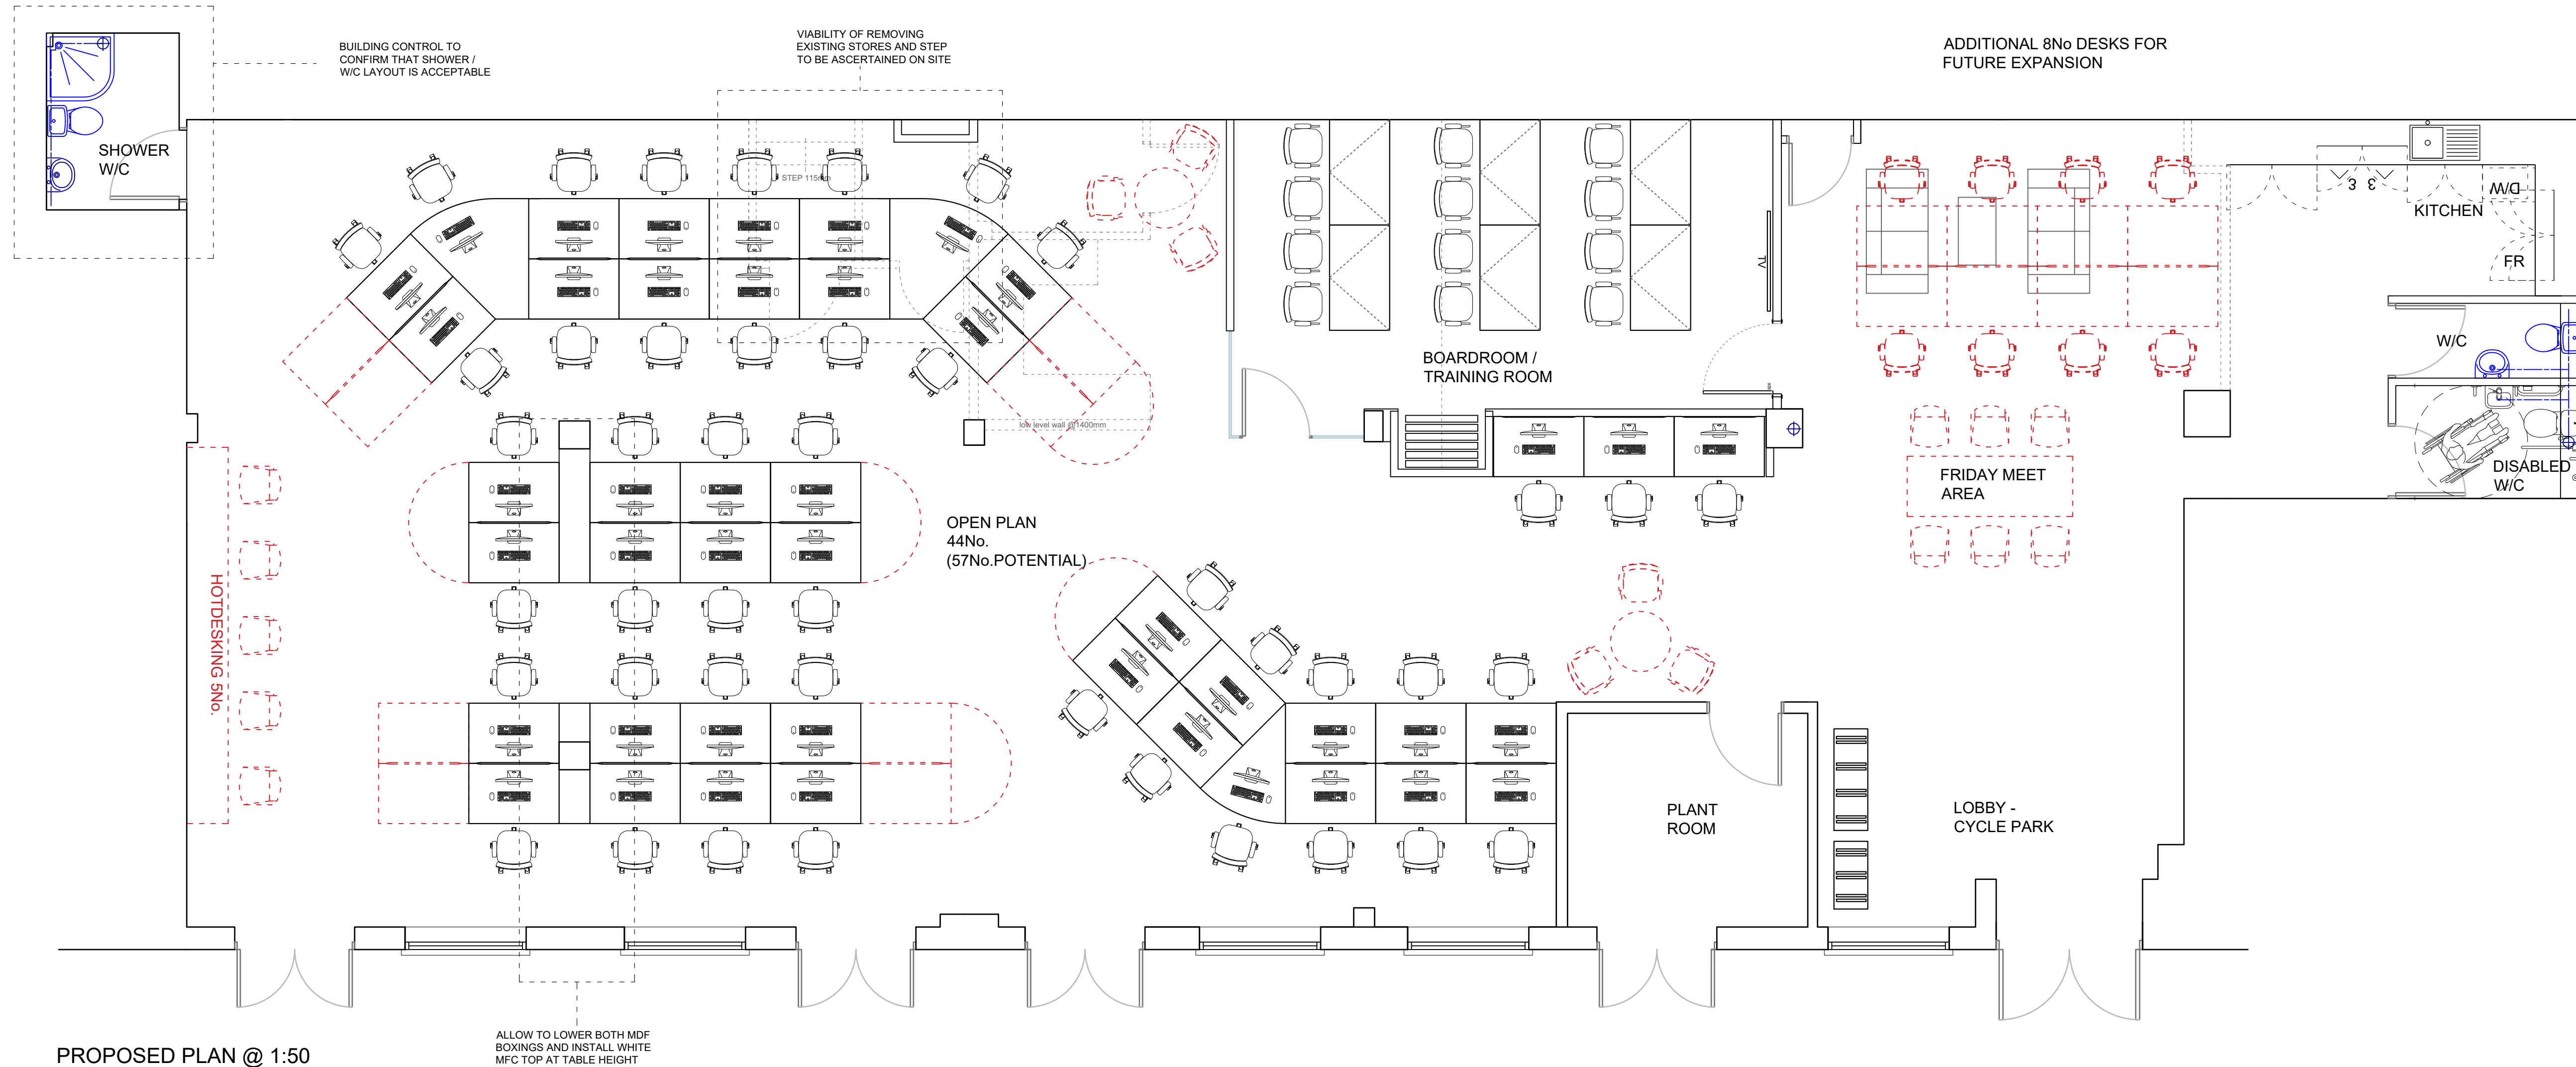

PROPOSED PLAN @ 1:50

J	AS BUILT	17.04.19
I	Update to construction issue - furniture shown as per cost plan.	8-2-18
H	Circular table removed in breakout - expansion desks shown in red in open plan	10-12-18
G	Possible expansion shown	4-12-18
F	Layout revd	29-11-18
E	Layout approved	23-11-18
D	Layout revisions following site visit	22-11-18
C	Layout revisions following layout development	15-11-18
B	Layout revisions following conference call.	14-11-18
A	Shower added	2-11-18

Rev:	Description:	Date:
------	--------------	-------

Client: Octopus Energy

Address: Argus Lofts
Robert Street
Brighton
East Sussex, BN1 4AH

Title: Proposed Layout

AS BUILT

APSS, Kingsley Road, Lincoln LN6 3TA

01522 688771

www.apss.co.uk

design@apss.co.uk

This drawing is copyright, the information contained within is confidential and may not be disclosed to third parties without the written permission of Acorn Partitioning & Storage Systems Ltd. ©2014
Please Note: This drawing is for information only. It is subject to change & should not be used by any other trade. Acorn Partitioning & Storage Systems Ltd. will not be held responsible for any work carried out, by any third parties, using this drawing.

Drawn: SW	Checked: -	Date: Oct 18
Scale: 1:50@A1	Number: 9312-02	Rev: J

