EXISTING FURNITURE

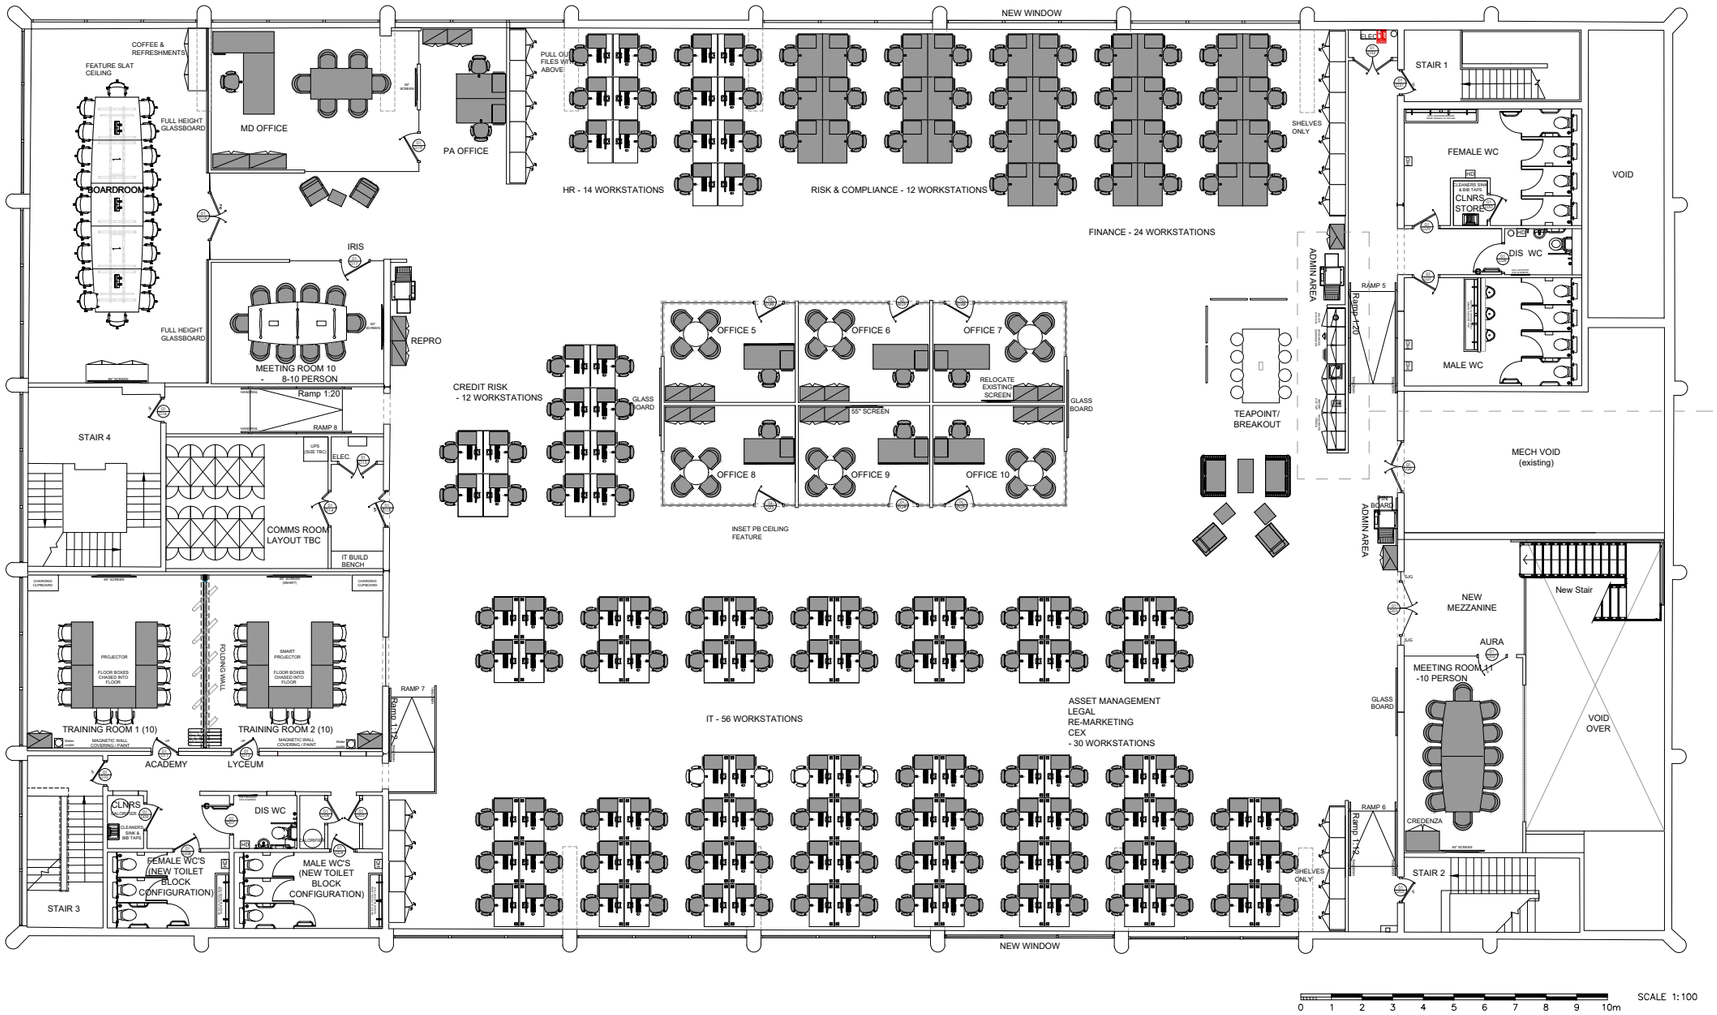

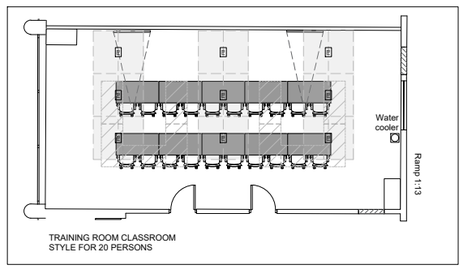

TRAINING ROOM CLASSROOM STYLE FOR 20 PERSONS

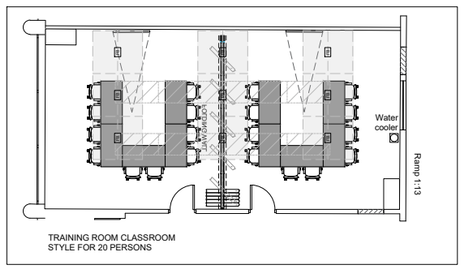

TRAINING ROOM CLASSROOM STYLE FOR 20 PERSONS

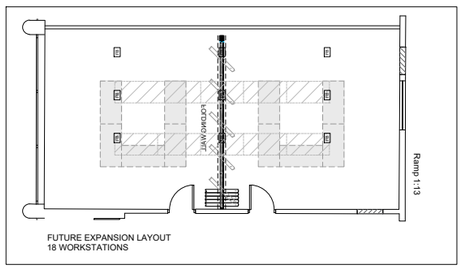

FUTURE EXPANSION LAYOUT 18 WORKSTATIONS

No part of this drawing can be copied without the written consent of Space & Solutions Ltd

No part of this drawing should be scaled. For dimensions and information relating to this drawing contact Space & Solutions Ltd. All contractors must visit site and be responsible for taking and checking dimesions

INFORMATION:

- Drawing Subject to Full Site Survey
- Building Parameter Provided to Space & Solutions Ltd
- Check Survey Undertaken Only

RECORD DRAWING

Space London
21 Ironmonger Lane
London // EC2V 8EY
T // +44 (0)20 3740 1080

Space South
9 Queensway // New Milton
Hampshire // BH25 5NN
T // +44 (0)1425 629 639

hello@spaceandsolutions.com
spaceandsolutions.com

REV.	DATE	REVISION INFO	DRAWN
--	--	--	--

SPACE

Approved: Date:

Drawing Title:
GENERAL ARRANGEMENT - FIRST FLOOR

Client:
MONEYBARN

Project:
NEW MINT HOUSE
BEDFORD ROAD
PETERSFIELD
HAMPSHIRE
GU32 3AL

Scale:	Date:	Drawn By:	Checked By:
1:100 @ A1	19/08/2018	LW	ST

Drawing Number

Project & Dwg No:	Level:	Type:	Rev:
19007	01	GA	RD

Status

☐ Information ☐ Tender ☐ Construction ☒ Record